


CERTIFIED RECORD OF LAND CORNER MONUMENTATION

History of original corner establishment:

Corner originally established by Charles M. Foster under Mineral Survey No. 505, surveyed under instructions dated April 5, 1904.

Original notes state:

A pine post, 4 ft long, 4 ins square set 18 ins in the ground, surrounded with a mound of earth, scribed C-2-505.

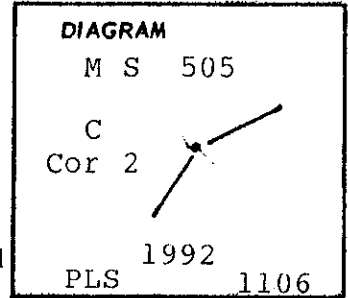

CASAUBON Cor. 2

Description of corner evidence found:

Found rotted post remains in mound of stone after determining search area by survey.

Description of monument and accessories established to perpetuate the original location of this corner

At position of found post remains...

Set 2½" x 30" aluminum pipe with 2½" aluminum cap 28" in ground and surrounded with a mound of earth and stone. Cap marked as shown in corner diagram.

New bearing trees established:

A 11" western larch brs S75°W, 47.6' scribed 2-C-505 BT.

A 9" lodgepole pine brs S66½°E, 21.3' scribed 2-C-505 BT.

New bearing trees have a brass washer stamped PLS 1106 nailed to face of blaze. Attached sign 54-3 & 54-9 to each BT & painted face of blaze & 6" red band around each BT. Set steel fence post on National Forest Boundary SW of corner with sign 54-2 & 54-9 attached.

Compass declination 18° East.

I hereby certify that the above corner was properly remonumented by me to U.S.F.S. standards on September 16, 1992.

REGISTERED
PROFESSIONAL
LAND SURVEYOR

William R. Wells

OREGON
JULY 22, 1977
WILLIAM R. WELLS
1106

Office of County Surveyor..... County of Baker
State of Oregon....., I hereby certify that the within instrument was filed in this office
for record on the day of

..... by

(COUNTY OFFICIAL) (DEPUTY)

FILED 3-24-93
BAKER COUNTY SURVEYOR
SURVEY NO. 8-36-85