


CERTIFIED RECORD OF LAND CORNER MONUMENTATION

History of original corner establishment:

Corner originally established by Charles M. Foster under Mineral Survey No. 505, surveyed under instructions dated April 5, 1904.

Original notes state:

A pine post 4 ft long, 4 ins square, set 18 ins in the ground, surrounded with a mound of earth, scribed C-5-505.

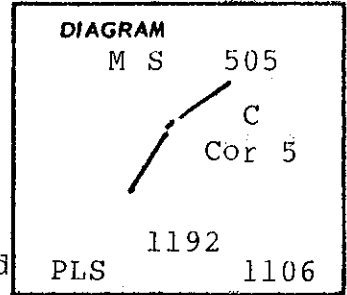

CASAUBON Cor 5

Description of corner evidence found:

Found rotted remains of post at ground level, after determining search area by survey.

Description of monument and accessories I established to perpetuate the original location of this corner

At position of found post remains...

Set 2 1/2" x 30" aluminum pipe with 2 1/2" aluminum cap 28" in ground and surrounded with a mound of earth and stone. Cap marked as shown in corner diagram. Placed post remains on the new mound.

New bearing trees established:

- A 9" western larch brs S03 1/4° W, 61.9' scribed 5-C-505 BT.
- A 8" western larch brs S54 1/2° W, 52.1' scribed 5-C-505 BT.

New bearing trees have a brass washer stamped PLS 1106 nailed to face of blaze. Attached sign 54-3 & 54-9 to each BT & painted face of blaze & 6" red band around each BT. Set steel fence post on National Forest Boundary NE of corner with sign 54-2 & 54-9 attached.

Compass declination 18° East.

I hereby certify that the above corner was properly remonumented by me to U.S.F.S. standards on September 16, 1992.

REGISTERED
PROFESSIONAL
LAND SURVEYOR

William R. Wells

OREGON
JULY 22, 1977
WILLIAM R. WELLS
1106

Office of County Surveyor County of Baker

State of Oregon, I hereby certify that the within instrument was filed in this office

for record on the day of

..... by

(COUNTY OFFICIAL)

(DEPUTY)

FILED 3-24-93

BAKER COUNTY SURVEYOR

SURVEY NO. 8-36-88