

CERTIFIED RECORD OF LAND CORNER MONUMENTATION


**History of original corner establishment:**

Corner originally established by Charles M. Foster under Mineral Survey No. 505, surveyed under instructions dated April 5, 1904.

**Original notes state:**

A pine post 4 ft long, 4 ins square, set 18 ins in the ground surrounded with a mound of earth, scribed C-N-E-M.S. 505, from which,

A fir 8 ins in diam bears N4<sup>0</sup>40'W, 26.2 ft dist blazed & scribed N.E. end cor. post MS 505 B.T.

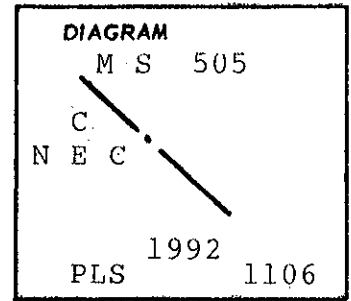

NORTH END CENTER CASAUBON

**Description of corner evidence found:**

Found post remains at ground level and original post with visible scribes lying on the ground, from which:

A 18" alpine fir brs N4 3/4<sup>0</sup>W, 26.4 ft with scribes visible on mostly healed blaze. (Original BT)

**Description of monument and accessories I established to perpetuate the original location of this corner**

At position of found post remains...

Set 2 1/2" x 30" aluminum pipe with 2 1/2" aluminum cap 28" in ground and surrounded with a mound of earth and stone. Cap marked as shown in corner diagram. Placed original post remains on mound.

**New bearing trees established:**

A 28" western larch brs N28 1/2<sup>0</sup>W, 108.8' scribed NEC-C-505 BT.

A 9" lodgepole pine brs S34 3/4<sup>0</sup>W, 54.3' scribed NEC-C-505 BT.

New bearing trees have a brass washer stamped PLS 1106 nailed to face of blaze. Attached sign 54-3 & 54-9 to each BT & painted face of blaze & 6" red band around each BT. Set steel fence post on National Forest Boundary NW of corner with sign 54-2 & 54-9 attached.

Compass declination 18<sup>0</sup> East.

I hereby certify that the above corner was properly remonumented by me to U.S.F.S. standards on September 11, 1992.

REGISTERED  
PROFESSIONAL  
LAND SURVEYOR

*William R. Wells*

OREGON  
JULY 22, 1977  
WILLIAM R. WELLS  
1106

Office of County Surveyor..... County of Baker.....

State of Oregon....., I hereby certify that the within instrument was filed in this office

for record on the ..... day of .....

..... by .....

(COUNTY OFFICIAL)

(DEPUTY)

FILED 3-23-93

BAKER COUNTY SURVEYOR

SURVEY NO. 8-36-90