

CERTIFIED RECORD OF LAND CORNER MONUMENTATION

History of original corner establishment:

Corner originally established by Charles M. Foster under Mineral Survey No. 505, surveyed under instructions dated April 5, 1904.

Original notes state:

A pine post 4 ft long, 4 ins square, set 18 ins in the ground surrounded with a mound of earth, scribed C-N-E-M.S.505, from which,

A fir 8 ins. in diam bears N4°40'W, 26.2 ft dist blazed & scribed N.E. end corner post MS 505 BT.

T 8 S R 36 E
MS 505
NEC C

Casaubon Cor. NEC

Corner was remonumented by: William R. Wells per Corner Record 8-36-90, dated 3-23-93

Found post remains at ground level and original post with visible scribes lying on the ground, from which:

A 18" alpine fir brs N4 3/4'W, 26.4 ft with scribes visible on mostly healed blaze. (Original BT)

At position of found post remains...

Set a 2 1/2" x 30" aluminum pipe with a 2 1/2" aluminum cap 28" in ground and surrounded with a mound of earth and stone. Cap marked as shown in corner diagram. Placed post remains on the new mound.

New bearing trees established:

A 28" western larch brs N28 1/2'W, 108.8 ' scribed NEC-C-505 BT.

A 9" lodgepole pine brs S34 3/4'W, 54.3' scribed NEC-C-505 BT.

New bearing tress have a brass washer stamped PLS 1106 nailed to the face of blaze. Attached 54-3 & 54-9 to each BT & painted face of blaze & 6" red band around each BT. Set a steel fence post on Nation Forest Boundary NE of corner with sign 54-2 & 54-9 attached.

Compass declination 18° East

I hereby certify that the above corner was properly remonumented by me to U.S.F.S. standards on September 11, 1992.

Continued on page 2 of 2

REGISTERED
PROFESSIONAL
LAND SURVEYOR

Kristina Powell

OREGON
MAY 9, 2017
KRISTINA POWELL
91201

EXPIRES 12-31-24

FILED January 3, 2024


BAKER COUNTY SURVEYOR
SURVEY NO. 8-36-102

CERTIFIED RECORD OF LAND CORNER MONUMENTATION

Description of corner evidence found:

2 of 2

A 2 1/2 inch aluminum pipe with a 2 1/2 inch aluminum cap, marked as shown. Firmly set flush with ground, with a rock collar.

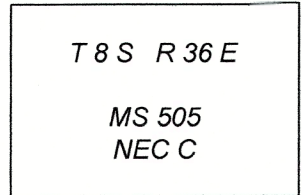

From which:


B.T.s, by Foster, not found

A 31 inch western larch (by Wells) with healed blaze, bears N28 1/2°W, 108.8 feet, alive and healthy.

Casaubon Cor. NEC

S.W. B.T., by Wells, destroyed

A steel T-post bears N44°W, 5 feet; with two (2) signs: Property Boundary, Land Survey Monument.

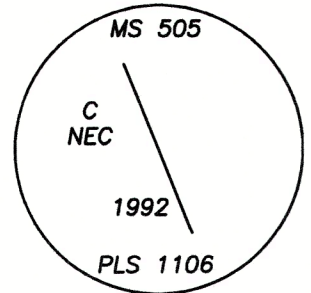

A steel T-post bears S44°E, 20 feet; with sign: Property Boundary.

Description of monument and accessories I established to perpetuate original location of this corner:

New Bearing Tree:

An 11 inch lodgepole pine scribed "NEC 505 BT", bears N52°E, 77.2 feet; measured to a 3/4 inch brass washer mkd: "LS 91201", at the right side of tree center.

Added Bearing Tree and Land Survey Monument signs as needed.

NAD 83 Geodetic Position

Lat. 44°49'31.7" N
Long. 118°15'09.6" W

Established by: Garmin ETREX 32x

I hereby certify that the corner is monumented and accessories taken as described using a steel tape and a Warren Knight staff compass, set with a declination of 14° East.

Witnesses: David Quittschreiber, Justin Seal, Shar Hutchison

August 9, 2023

REGISTERED
PROFESSIONAL
LAND SURVEYOR

Kristina Powell

OREGON
MAY 9, 2017
KRISTINA POWELL
91201

EXPIRES 12-31-24

FILED January 3, 2024
BAKER COUNTY SURVEYOR
SURVEY NO. 8-36-102