


CERTIFIED RECORD OF LAND CORNER MONUMENTATION

R-25

History of original corner establishment:

Corner established by Lincoln E. Wilkes under instructions dated Sept. 24, 1923, and included in Group No. 107.

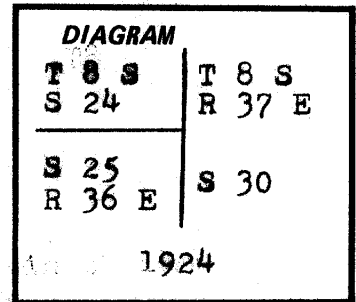

Surveyor General records state:

Set an iron post, 3 ft. long, 2 ins. dia., 27 ins. in the ground, for cor. of secs. 24 and 25 only, with brass cap marked as shown in corner diagram:

from which:

- A balsam, 6 ins. dia., bears S. 2½° W., 45 lks. dist., marked T 8 S R 36 E S 25 BT.
- A Black pine, 7 ins. dia., bears N. 60° W., 6½ lks. dist., marked T 8 S R 36 E S 24 BT.

Description of corner evidence found:

A brass cap on an iron pipe marked as shown in corner diagram.

- An 8" snag bears N 60° W., 6½ lks. dist with visible scribes.
- A fir 12" diam. bears S 2½° W., 45 lks. dist. with healed blaze.

Description of monument and accessories established to perpetuate the original location of this corner:

Improved surrounding rock mound around corner monument and set a 6 foot steel fence post alongside with a sign 54-9 attached.

New bearing tree:

A spruce 15 inches diam. bears N 72° W., 7.5 ft. dist. marked T 8 S R 36 E S 24 BT and has a brass washer marked PLS 1639 nailed flush with BT blaze.

To each bearing tree attached a sign 54-3 above BT blaze and below a 6 inch band of red paint and a sign 54-9 attached to opposite side of tree from BT blaze.

I hereby certify that the above corner monument was properly maintained to U.S.F.S. standards under my supervision on Oct. 8, 1984, and witnessed by Jim DeMastus and Daryl Schuchardt.

**REGISTERED
PROFESSIONAL
LAND SURVEYOR**

William L. Hanley

**OREGON
JULY 14, 1978
WILLIAM L. HANLEY
1639**

Office of County Surveyor County of Baker
 State of Oregon I hereby certify that the within instrument was filed in this office
 for record on the 11 day of June 1985
 by
 (COUNTY OFFICIAL) (DEPUTY)

FILED 6-11-85
 BAKER COUNTY SURVEYOR
 SURVEY NO. 8-36-3