


CERTIFIED RECORD OF LAND CORNER MONUMENTATION

V-25

History of original corner establishment:

Corner established by Lincoln E. Wilkes under insturotions dated Sept. 24, 1923 and included in Group No. 107.

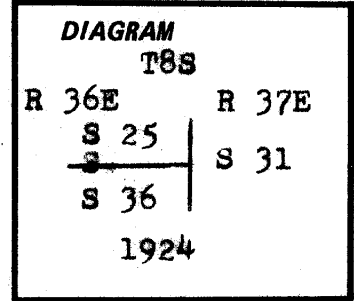

Surveyor General records state:

...set an iron post, 3 ft. long, 2 ins. dia., 27ins. in the ground, for cor. of sess. 25 and 36, only, with brass cap marked as shown in diagram from which:

- A fir, 5 ins. dia., bears S. 20° W., 95 lks. dist., marked T 8 S R 36 E S 36 BT.
- A Fir, 5 ins. dia., bears N. 31½° W., 145 lks. dist., marked T 8 S R 36 E S 25 BT.

Description of corner evidence found:


- A brass cap on an iron pipe marked as shown in corner diagram.
- A fir 16" diam. bears S 20° W, 95 lks. dist. with healed blaze.
- A fir 17" diam. bears N 31½° W., 145lks. dist. with healed blaze.

Description of monument and accessories | established to perpetuate the original location of this corner:

Improved surrounding rock mound around corner monument and set a 6 foot steel fence post alongside with a sign 54-9 attached.

Attached a sign 54-3 above BT blaze and below a 6 inch band of red paint and a sign 54-9 attached to opposite side of tree from BT blaze to each of the original bearing trees.

I hereby certify that the above described corner monument was properly maintained to Forest Service standards under my supervision and on Oct. 2, 1984, and witnessed by Jim DeMastus and Daryl Schuchardt.

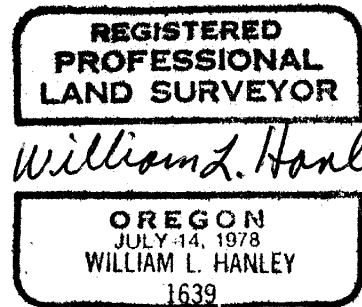

Office of Baker County Surveyor..... County of Baker.....  
 State of Oregon....., I hereby certify that the within instrument was filed in this office  
 for record on the 11 day of June....., 1985  
 ..... by .....  
 (COUNTY OFFICIAL) (DEPUTY)

FILED 6-11-85  
 BAKER COUNTY SURVEYOR  
 SURVEY NO. 8-36-5