


CERTIFIED RECORD OF LAND CORNER MONUMENTATION

Z-25

History of original corner establishment:
Corner established by Lincoln E. Wilkes under instructions dated Sept. 24, 1923, and contained in Group No. 107.

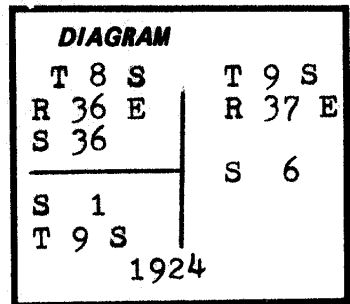

Surveyor General records state:

...Set an iron post, 3 ft long, 3 ins dia, 27 ins in the ground, with brass cap marked..(as shown in diagram) from which:

A tamarack 18 ins dia bears S 42° W, 51 lks dist marked T 9 S R 36 E S 1 BT
A tamarack 24 ins dia bears N 39° W, 88 lks dist marked T 9 S R 36 E S 36 BT

Description of corner evidence found:

Section 36 BT is a 29 inch tamarack with healed blaze.

Section 1 BT is a 24 inch tamarack with healed blaze.

Brass cap monument found as per official record and marked as shown in diagram.

Description of monument and accessories | established to perpetuate the original location of this corner:

Improved surrounding rock mound around corner monument and set a 6 foot steel fence post alongside with a sign 54-9 attached.

Each original bearing tree has a sign 54-3 attached above the BT blaze and has a sign 54-9 attached on the opposite side and has a 6 inch band of red paint around.

I hereby certify that the above corner monument was properly maintained to U.S.F.S. standards under my supervision on Oct. 2, 1984, and witnessed by Jim DeMastus and Daryl Schuchardt.



Office of Surveyor County of Baker
 State of Oregon, I hereby certify that the within instrument was filed in this office
 for record on the 11 day of June, 1985
 by _____
 (COUNTY OFFICIAL) (DEPUTY)

FILED 6-11-85
 BAKER COUNTY SURVEYOR
 SURVEY NO. 8-36-7