


CERTIFIED RECORD OF LAND CORNER MONUMENTATION

History of original corner establishment:

The corner was originally established by Arthur Philbrick under Mineral Survey No. 477, during June and July 1902. The original notes state that at the corner a scribed tamarack post 4' long by 4" sq. was set 12" in the ground and surrounded with a mound of earth from which:
A 20" tamarack bears N52°E-11.45'.
A 6" black pine bears S40°50'W-7.92'.
Both marked B.T.W. 4-R. 7-477.

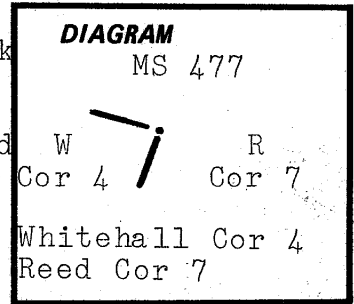

Description of corner evidence found:

Found an earth mound with remains of post at ground level and the original wood post lying beside the mound. From the post hole:
A 24" western larch bears N52°E-12.2' with healed blaze (original bearing tree).
A 7" dead and down lodgepole pine bears S40 3/4°W-7.9' with visible scribing on open blaze (original bearing tree).

Description of monument and accessories established to perpetuate the original location of this corner:

Set a 2 1/2" by 30" aluminum pipe with a 2 1/2" aluminum cap 20" in the ground and surrounded with a mound of earth and stone. Placed original wood post on mound. From the monument:

A 9" white fir bears S65 1/2°E-20.5' scribed 4-W-7-R-477 BT.
New bearing tree has a brass washer stamped PLS 1106 nailed to face of blaze. Attached signs 54-9 and 54-3 to each bearing tree and painted face of blaze and a 6" red band around each bearing tree. Set steel fence post on claim line near corner and attached sign 54-9.

Cap is marked:
MS 477

Used steel tape and staff compass with 20°E declination, measured to the center of the bearing trees.



This corner was remonumented on July 25, 1985.

Witness: John Tuttle

1985
PLS 1106

**REGISTERED
PROFESSIONAL
LAND SURVEYOR**

William R. Wells

**OREGON
JULY 22, 1977
WILLIAM R. WELLS
1106**

Office of.....County Surveyor..... County of..... Baker
State of..... Oregon....., I hereby certify that the within instrument was filed in this office
for record on the...27... day of..... Aug....., 19...85
..... by
(COUNTY OFFICIAL) (DEPUTY)

FILED 8-27-85
BAKER COUNTY SURVEYOR
SURVEY NO. 8-36-109