


CERTIFIED RECORD OF LAND CORNER MONUMENTATION

History of original corner establishment:

The corner was originally established by Arthur Philbrick under Mineral Survey No. 477, during June and July 1902. The original notes state that at the corner a scribed black pine post 4' long and 4" sq. was set 12" in the ground and surrounded with a mound of earth from which:
A 6" spruce bears S84°30'E-3.2'.
A 12" black pine bears N3°52'E-25.6'.
Both marked B.T.W. 5-R. 6-477.

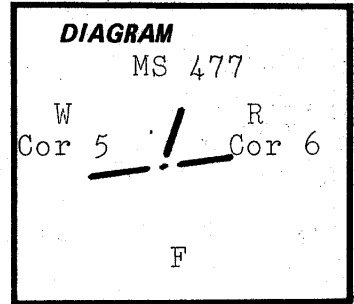

Whitehall Cor 5
Reed Cor 6

Description of corner evidence found:

Found the original post hole below ground level. Also, found remains of post above ground. From the original post hole:

An 11" dead spruce bears S84½°E-3.5' with scribing visible on partly healed blaze (original bearing tree).
A 12" dead lodgepole pine bears N4°E-25.9' with scribing visible on open blaze (original bearing tree).

Description of monument and accessories | established to perpetuate the

original location of this corner:

Set a 2½" by 30" aluminum pipe with a 2½" aluminum cap 22" in the ground and surrounded with a mound of earth and stone. Placed remains of wood post on the mound. From the monument:


A 14" Engleman spruce bears N56½°W-25.5' scribed 5-W-6-R-477 BT.
An 18" Engleman spruce bears N85½°E-16.4' scribed 5-W-6-R-477 BT.
Each new bearing tree has a brass washer stamped PLS 1106 nailed to the face of blaze. Attached signs 54-3 and 54-9 to each bearing tree and painted the face of blaze and a 6" red band around each bearing tree. Set steel fence post on claim line near corner and attached sign 54-9.

Used steel tape and staff compass with 20°E declination, measured to the center of the bearing trees.

This corner was remonumented on July 25, 1985.

Witness: John Tuttle

Cap is marked:

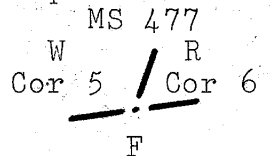

1985
PLS 1106

**REGISTERED
PROFESSIONAL
LAND SURVEYOR**

William R. Wells

**OREGON
JULY 22, 1977
WILLIAM R. WELLS
1106**

Office of.....County Surveyor..... County of..... Baker.....

State of.....Oregon....., I hereby certify that the within instrument was filed in this office
for record on the...27... day of..... Aug....., 19.85

..... by
(COUNTY OFFICIAL) (DEPUTY)

FILED 8-27-85
BAKER COUNTY SURVEYOR
SURVEY NO. 8-36-H 10