


CERTIFIED RECORD OF LAND CORNER MONUMENTATION

History of original corner establishment:

The corner was originally established by Arthur Philbrick under Mineral Survey No. 477, during June and July 1902. The original notes state that at the corner a scribed black pine post 4' long by 4" sq. was set 12" in the ground and surrounded with a mound of earth from which:
A 12" pine bears N89°40'W-15.5'.
A 10" spruce bears S5°E-21'.
Both marked B.T.W.E.C.-477.

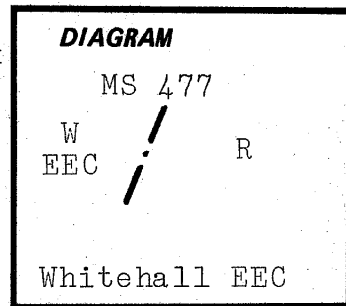

Description of corner evidence found:


Found a mound of earth and remains of wood post at ground level from which:
A 12" dead Lodgepole pine bears N89 3/4°W-15.7' with visible scribing on open blaze (original bearing tree).

Description of monument and accessories I established to perpetuate the original location of this corner:

Set a 2 1/2" by 30" aluminum pipe with a 2" aluminum cap 24" in the ground and surrounded with a mound of earth and stone, from which:
A 6" alpine fir bears N65 1/2°W-11.5' scribed EEC-W-477 BT.
A 6" alpine fir bears S60°W-10.8' scribed EEC-W-477 BT.
New bearing trees have a brass washer stamped PLS 1106 nailed to the face of blaze. Attached signs 54-9 and 54-3 to each bearing tree and painted face of blaze and a 6" red band around each bearing tree. Set steel fence post on claim line near corner and attached sign 54-9.
Used steel tape and staff compass with 20°E declination, measured to the center of the bearing trees.

Cap is marked:
MS 477
W EEC / R
1985
PLS 1106

This corner was remonumented on July 25, 1985.
Witness: John Tuttle

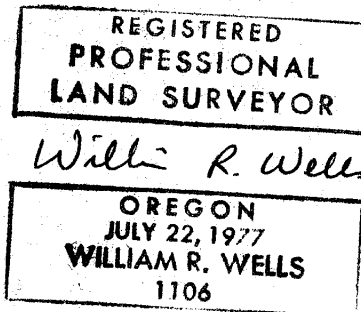

Office of... County Surveyor..... County of... Baker
State of... Oregon....., I hereby certify that the within instrument was filed in this office for record on the... 27... day of... Aug....., 19 85
..... by
(COUNTY OFFICIAL) (DEPUTY)

FILED 8-27-85
BAKER COUNTY SURVEYOR
SURVEY NO. 8-36-111