


CERTIFIED RECORD OF LAND CORNER MONUMENTATION

History of original corner establishment:

The corner was originally established by Arthur Philbrick under Mineral Survey No. 477, during June and July 1902. The original notes state that at the corner a scribed black pine post 4' long by 4" sq. was set 12" in the ground and surrounded with a mound of earth from which:
A 12" tamarack bears N88°20'W-44.60'.
A 3" tamarack bears S1°20'E-16.46'.
Both marked B.T.K.E.C.-477.

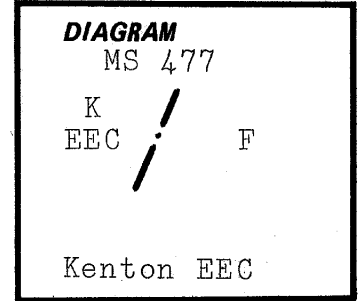

Description of corner evidence found:

Found a mound of earth with a hole in the middle and rotted remains of post below ground. Also, found remains of original post lying beside mound. From the original post hole:

A 16" western larch bears N86½°W-44.9' with healed blaze (original bearing tree).
A 5" dead, standing western larch bears S1½°E-16.5' with visible scribing on partly healed blaze (original bearing tree).

Description of monument and accessories established to perpetuate the original location of this corner:

Set a 2½" by 30" aluminum pipe with a 2½" aluminum cap 22" in the ground and surrounded with a mound of earth and stone. Placed remains of original post on the mound. From the monument:


A 7" alpine fir bears S1½°W-32.5' scribed EEC-K-477 BT.
New bearing tree has a brass washer stamped PLS 1106 nailed to the face of blaze. Attached signs 54-3 and 54-9 to each bearing tree and painted face of blaze and a 6" red band around each bearing tree. Set steel fence post on claim line near corner and attached sign 54-9.

Used steel tape and staff compass with 20°E declination, measured to the center of the bearing trees.

This corner was remonumented on July 25, 1985.

Witness: John Tuttle

Cap is marked:
MS 477

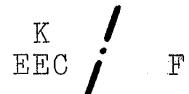

1985
PLS 1106

**REGISTERED
PROFESSIONAL
LAND SURVEYOR**

William R. Wells

**OREGON
JULY 22, 1977
WILLIAM R. WELLS
1106**

Office of.....County Surveyor.....County of.....Baker.....
State of.....Oregon....., I hereby certify that the within instrument was filed in this office
for record on the...27... day of.....Aug....., 1985
..... by
(COUNTY OFFICIAL) (DEPUTY)

FILED 8-27-85
BAKER COUNTY SURVEYOR
SURVEY NO. 8-36-1312