


CERTIFIED RECORD OF LAND CORNER MONUMENTATION

History of original corner establishment:

The corner was originally established by Arthur Philbrick under Mineral Survey No. 477, during June and July 1902. The original notes state that at the corner a scribed black pine post 4' long by 4" sq. was set 12" in the ground from which:
A 12" red fir bears S20°52'W-65.66'.
A 6" red fir bears S69°40'E-49.86'.
Both marked B.T.E.F.S.C.-477.

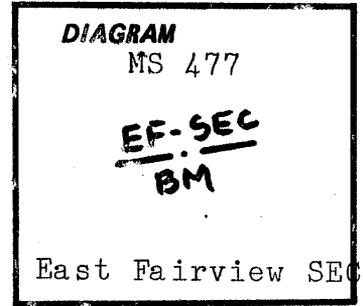

Description of corner evidence found:

Found the rotted remains of the post at ground level and the rotten remains of the post lying beside the post hole. From the corner:

A 26" white fir stump bears S69°E-50.3' with catface (original bearing tree).
A 28" white fir stump bears S21½°W-66.5' with catface (original bearing tree).

Description of monument and accessories I established to perpetuate the original location of this corner:

Set a 2½" by 30" aluminum pipe with a 2½" aluminum cap 24" in the ground and surrounded with a mound of earth and stone. Placed remains of the original post on the mound. From the monument:

A 6" western larch bears S74°E-6.6' scribed SEC-EF-477 BT.
An 8" lodgepole pine bears S82°W-28.0' scribed SEC-EF-477 BT.
New bearing trees have a brass washer stamped PLS 1106 nailed to the face of blaze. Attached signs 54-9 and 54-3 to each bearing tree and painted the face of blaze and a 6" red band around each bearing tree. Set steel fence post on claim line and attached sign 54-9.

Used steel tape and staff compass with 20°E declination, measured to the center of the bearing trees.

This corner was remonumented on July 26, 1985.

Witness: John Tuttle

Cap is marked:

MS 477
EF-SEC
BM

1985
PLS 1106

REGISTERED
PROFESSIONAL
LAND SURVEYOR

William R. Wells

OREGON
JULY 22, 1977
WILLIAM R. WELLS
1106

Office of..... County Surveyor..... County of..... Baker.....
State of..... Oregon..... I hereby certify that the within instrument was filed in this office
for record on the 27 day of Aug., 1985
..... by

(COUNTY OFFICIAL)

(DEPUTY)