


CERTIFIED RECORD OF LAND CORNER MONUMENTATION

History of original corner establishment:

The corner was originally established by Arthur Philbrick under Mineral Survey No. 477, during June and July 1902. The original notes state that at the corner a scribed pine post 4' long by 4" sq. was set 12" in the ground and surrounded with a mound of earth from which: Cor. 1, Ibex Lode, MS No. 421, bears S48°53'W-97.33'.

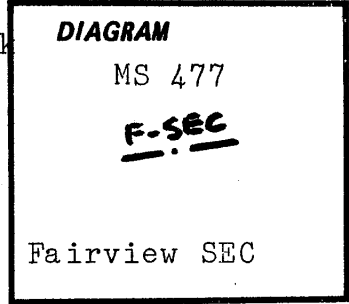

Description of corner evidence found:

Found a mound of earth and stone and the remains of the post in the mound. Portion of the original post with scribing visible was lying on the mound.

Description of monument and accessories established to perpetuate the original location of this corner:

Set a 2½" by 30" aluminum pipe with a 2½" aluminum cap 20" in the ground and surrounded with a mound of earth and stone. Placed the remains of the original post on the mound. From the monument:

A 6" white fir bears N71°W-22.7' scribed SEC-F-477 BT.
A 10" alpine fir bears S43¼°W-25.6' scribed SEC-F-477 BT.
New bearing trees have a brass washer stamped PLS 1106 nailed to the face of blaze. Attached signs 54-9 and 54-3 to each bearing tree and painted face of blaze and a 6" red band around each bearing tree. Set steel fence post on National Forest Boundary SW and NE of corner and attached sign 54-9 to one post and sign 54-2 to both posts.

Used steel tape and staff compass with 20°E declination, measured to the center of the bearing trees.

Cap is marked:
MS 477

F-SEC

This corner was remonumented on July 24, 1985.

Witness: John Tuttle

1985
PLS 1106

REGISTERED
PROFESSIONAL
LAND SURVEYOR

William R. Wells

OREGON
JULY 22, 1977
WILLIAM R. WELLS
1106

Office of..... County Surveyor..... County of..... Baker
State of..... Oregon....., I hereby certify that the within instrument was filed in this office
for record on the... 27... day of..... Aug....., 19.. 85
..... by
(COUNTY OFFICIAL) (DEPUTY)

FILED 8-27-85
BAKER COUNTY SURVEYOR
SURVEY NO. 8-36-2522
9-36-