


**CERTIFIED RECORD OF LAND CORNER MONUMENTATION**

**History of original corner establishment:**

The corner was originally established by Arthur Philbrick under Mineral Survey No. 477, during the survey of June and July 1902. The original notes state that at the corner a scribed black pine post 4' long by 4" sq. was set 12" in the ground and surrounded with a mound of earth from which:

- An 8" black pine bears S81°26'E-14.60'.
- A 14" black pine bears S74°45'W-8.57'.
- Both marked B.T.K.W.C.-477.

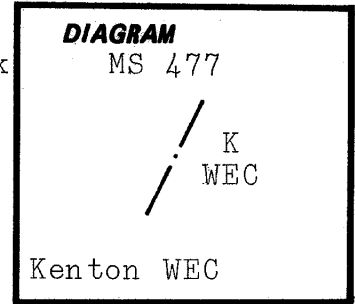

**Description of corner evidence found:**

Found a mound of earth and stone with the remains of post at ground level and remains of the post by the mound. From the mound:

- A 15" standing dead lodgepole pine bears S80½°E-15.1' with scribing visible on open blaze (original bearing tree).
- A 13" down lodgepole pine bears S75°W-8.5'± with scribing under the tree (original bearing tree).

**Description of monument and accessories I established to perpetuate the original location of this corner:**

Set a 2½" by 30" aluminum pipe with a 2½" aluminum cap 24" in the ground and surrounded with a mound of earth and stone and placed remains of post on mound. From the monument:

- An 8" engleman spruce bears S85°W-18.9' scribed WEC-K-477 BT.
- A 9" alpine fir bears N53½°W-37.1' scribed WEC-K-477 BT.
- New bearing trees have a brass washer stamped PLS 1106 nailed to face of blaze. Attached signs 54-9 and 54-3 to each bearing tree and painted face of blaze and a 6" red band around each bearing tree. Set steel fence posts on National Forest Boundary NE and SW of corner and attached sign 54-9 to one post and sign 54-2 to both posts.

Used steel tape and staff compass with 20°E declination, measured to the center of the bearing trees.

Cap is marked:  
MS 477

This corner was remonumented on August 9, 1985.

Witness: John Tuttle

REGISTERED  
 PROFESSIONAL  
 LAND SURVEYOR

*William R. Wells*

OREGON  
 JULY 22, 1977  
 WILLIAM R. WELLS  
 1106

/  
 K  
 WEC  
 1985  
 PLS 1106

Office of... County Surveyor..... County of... Baker.....  
 State of... Oregon....., I hereby certify that the within instrument was filed in this office  
 for record on the... 8... day of... Oct....., 1985  
 ..... by .....  
 (COUNTY OFFICIAL) (DEPUTY)