


CERTIFIED RECORD OF LAND CORNER MONUMENTATION

History of original corner establishment:

The corner was originally established by Arthur Philbrick under Mineral Survey No. 477, during the survey of June and July 1902. The original notes state that at the corner a scribed black pine post 4' long by 4" sq. was set 12" in the ground and surrounded with a mound of earth from which:

- A 6" black pine bears N71°47'E-7.68'.
- A 4" black pine bears N31°05'W-12.08'.
- Both marked B.T.K.2-477.

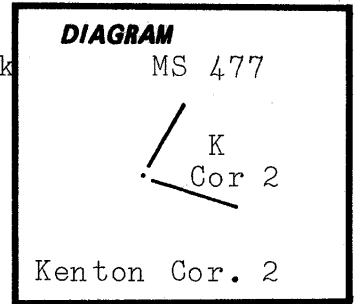

Description of corner evidence found:

Found a mound of earth and the remains of the rotted post at ground level and the original post lying beside the mound. From the mound:


A 10" live lodgepole pine bears N73½°E-7.9' with scribing visible on partly healed blaze (original bearing tree).

Description of monument and accessories I established to perpetuate the original location of this corner:

Set a 2½" by 30" aluminum pipe with a 2½" aluminum cap 24" in the ground and surrounded with a mound of earth and stone. Placed the remains of the original post on the mound. From the monument:

A 7" engleman spruce bears S51½°W-21.2' scribed 2-K-477 BT. The new bearing tree has a brass washer stamped PLS 1106 nailed to face of blaze. Attached signs 54-3 and 54-9 to each bearing tree and painted face of blaze and a 6" red band around each bearing tree. Set steel fence posts on National Forest Boundary NE and SE of corner and attached sign 54-9 to one post and sign 54-2 to both posts.

Cap is marked:
MS 477

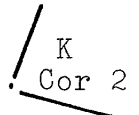

Used steel tape and staff compass with 20°E declination, measured to the center of the bearing trees.

This corner was remonumented on August 9, 1985.

1985
PLS 1106

Witness: John Tuttle

REGISTERED
PROFESSIONAL
LAND SURVEYOR

William R. Wells

OREGON
JULY 22, 1977
WILLIAM R. WELLS
1106

Office of...County...Surveyor..... County of...Baker.....
State of...Oregon....., I hereby certify that the within instrument was filed in this office
for record on the...8... day of...Oct....., 1985
..... by
(COUNTY OFFICIAL) (DEPUTY)