


CERTIFIED RECORD OF LAND CORNER MONUMENTATION

History of original corner establishment:

The corner was originally established by Arthur Philbrick under Mineral Survey No. 477, in June and July, 1902. The original notes state that at the corner a 4' long by 4" square scribed black pine post was set 12" in the ground and surrounded with a mound of earth and stone from which:

- A 10" black pine bears $S1^{\circ}20'E-19.63'$.
- A 4" black pine bears $N71^{\circ}35'E-7.89'$.
- Both scribed B.T.R.E.C.-477.

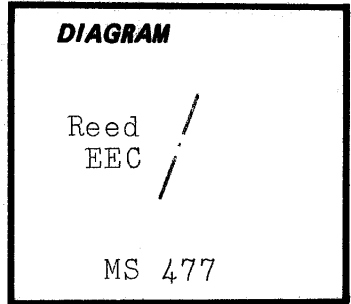

Description of corner evidence found:

Found a mound of stone with rotted remains of post at ground level from which:

- A down, rotten, lodgepole pine bears $S1^{\circ}4'E-19.6' \mp$, with axe marks and fragmentary scribing visible on the old blaze face. (Original bearing tree).
- A root hole bears $N71^{\circ}2'E-8' \mp$.

Also found remains of the original wood post lying beside the stone mound.

Description of monument and accessories established to perpetuate the original location of this corner:

Set a 2 1/2" by 30" aluminum pipe with 2 1/2" aluminum cap 15" in the ground and surrounded with a mound of earth and stone from which:

- A 12" western larch bears $N48^{\circ}E-32.0'$, scribed EEC-R-477 BT.
- A 13" alpine fir bears $S89^{\circ}1'E-29.2'$, scribed EEC-R-477 BT.

Placed remains of the original post on the mound.

Each new bearing tree has a brass washer stamped PLS 1106 nailed to the face of blaze. Attached sign 54-3 and 54-9 and painted face of blaze and a 6" red band around each bearing tree. Set steel fence post on National Forest Boundary Northesat and Southwest of corner and attached sign 54-9 to one post and sign 54-2 to both posts.

Used staff compass with $20^{\circ}E$ declination, measured to the center of the bearing trees.

Cap Marked:

MS 477

R
EEC

1985
PLS 1106

Witness: Willard Hulick

REGISTERED
PROFESSIONAL
LAND SURVEYOR

William R. Wells

OREGON
JULY 22, 1977
WILLIAM R. WELLS
1106

Office of.....County Surveyor.....County of.....Baker.....
 State of.....Oregon....., I hereby certify that the within instrument was filed in this office
 for record on the...8... day of.....Oct....., 1985
 by
 (COUNTY OFFICIAL) (DEPUTY)