


CERTIFIED RECORD OF LAND CORNER MONUMENTATION

History of original corner establishment:

This corner was originally established by Arthur Philbrick under Mineral Survey No. 477, during June and July 1902. The original notes state that at the corner a scribed black pine post 4' long by 4" sq. was set 12" in the ground and surrounded with a mound of earth and stone from which:
A 6" black pine bears N37°E-8.1'.
An 8" black pine bears N73°W-8.95'.
Both marked B.T.R.3-477.

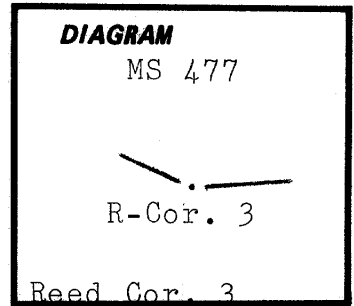

Description of corner evidence found:

Found the rotted remains of the post at ground level from which:

A very rotten up-rooted lodgepole pine bears N37°E-8.1'± with axe marks visible on part of blaze (original bearing tree).
A very rotten down lodgepole pine bears N73°W-9'± with fragmentary scribing (original bearing tree).

Description of monument and accessories established to perpetuate the original location of this corner:

Set a 2½" by 30" aluminum pipe with a 2½" aluminum cap 20" in the ground and surrounded with a mound of earth and stone from which:

An 8" white fir bears N58½°E-20.9' scribed 3-R-477 BT.
A 9" white fir bears N36°W-25.3' scribed 3-R-477 BT.
New bearing trees have a brass washer stamped PLS 1106 nailed to face of blaze. Attached signs 54-3 and 54-9 to each bearing tree and painted face of blaze and a 6" red band around each bearing tree. Set steel fence posts on National Forest Boundary NW and NE of corner and attached sign 54-9 to one post and sign 54-2 to both posts.

Used steel tape and staff compass with 20°E declination, measured to the center of the bearing trees.

Cap is marked:
MS 477

This corner was remonumented on August 28, 1985.

R-Cor 3
1985
PLS 1106

Witness: John Tuttle

REGISTERED
PROFESSIONAL
LAND SURVEYOR

William R. Wells

OREGON
JULY 22, 1977
WILLIAM R. WELLS
1106

Office of... County Surveyor County of... Baker
State of... Oregon I hereby certify that the within instrument was filed in this office
for record on the... 8... day of... Oct. , 1985
..... by
(COUNTY OFFICIAL) (DEPUTY)

FILED
BAKER COUNTY CLERK
SEP 11 1985
8-36-36