


CERTIFIED RECORD OF LAND CORNER MONUMENTATION

History of original corner establishment:

The corner was originally established by Arthur Philbrick under Mineral Survey No. 477, during the survey of June and July 1902. The original notes state that at the corner a scribed black pine post 4' long by 4"sq. was set 12" in the ground from which:

A 6" black pine bears S37°26'E-21.46' scribed B.T.W.3-477.

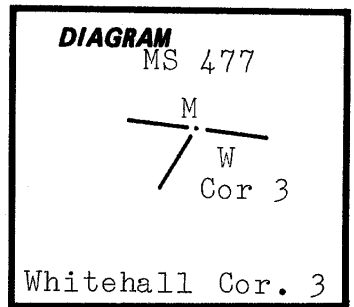

Description of corner evidence found:

Found a mound of earth with the remains of the rotted post at ground level from which:

An 11" dead standing lodgepole pine bears S35½°E-21.6' with healed blaze which when opened revealed scribing (original bearing tree).

A 13" dead standing lodgepole pine bears N17°W-25.5' with partly healed blaze (original bearing tree). There is no original record of the bearing tree.

Description of monument and accessories established to perpetuate the original location of this corner:

Set a 2½" by 30" aluminum pipe with a 2½" aluminum cap 24" in the ground and surrounded with a mound of earth and stone. Placed the remains of the post on the mound. From the monument:

A 10" engleman spruce bears S84½°E-15.9' scribed 3-W-477 BT.

An 11" engleman spruce bears S66½°W-43.0' scribed 3-W-477 BT.

New bearing trees have a brass washer stamped PLS 1106 nailed to face of blaze. Attached sign 54-3 and 54-9 to each bearing tree and painted face of blaze and a 6" red band around each bearing tree. Set steel fence post on National Forest Boundary NW and SW of corner and attached sign 54-9 to one post and sign 54-2 to both posts.


Used steel tape and staff compass with 20°E declination, measured to the center of the bearing trees.

This corner was remonumented on August 9, 1985.

Witness: John Tuttle

Cap is marked:

MS 477

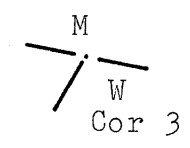

1985
PLS 1106

REGISTERED
PROFESSIONAL
LAND SURVEYOR

William R. Wells

OREGON
JULY 22, 1977
WILLIAM R. WELLS
1106

Office of County Surveyor..... County of Baker

State of Oregon....., I hereby certify that the within instrument was filed in this office for record on the 8th day of Oct., 1985

..... by

(COUNTY OFFICIAL)

(DEPUTY)