


CERTIFIED RECORD OF LAND CORNER MONUMENTATION

History of original corner establishment:

The corner was originally established by Arthur Philbrick under Mineral Survey No. 477, during June and July 1902. The original notes state that at the corner a scribed tamarack post 4' long by 4" sq. was set 12" in the ground and surrounded with a mound of stone from which:
A 12" red fir bears N38°15'W-29.2'.
An 8" red fir bears S66°E-10.8'.
Both marked B.T.C.2-477.

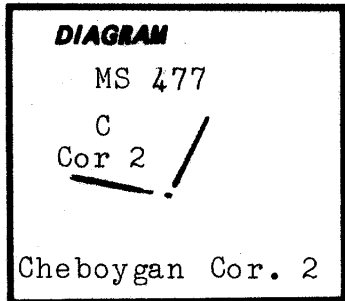

Description of corner evidence found:

The rotted remains of the post at ground level in a mound of stone from which:
A 22" white fir stump bears N36°W-29.4' (original bearing tree).
A 22" white fir stump bears S66°E-11.5' with catface (original bearing tree).


Description of monument and accessories established to perpetuate the original location of this corner:

Set a 2½" by 30" aluminum pipe with a 2½" aluminum cap 15" in the ground and surrounded with a mound of earth and stone from which:

An 8" white fir bears N13½°W-48.4' scribed 2-C-477 BT.
A 7" white fir bears S50½°E-27.6' scribed 2-C-477 BT.
New bearing trees have a brass washer stamped PLS 1106 nailed to face of blaze. Attached signs 54-3 and 54-9 to each bearing tree and painted face of blaze and a 6" red band around each bearing tree. Set steel fence posts on National Forest Boundary NW and NE of corner and attached sign 54-9 to one post and sign 54-2 to both posts.

Cap is marked:

MS 477

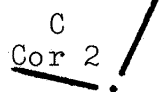

Used steel tape and staff compass with 20°E declination, measured to the center of the bearing trees.

This corner was remonumented on August 28, 1985.

Witness: John Tuttle

1985
PLS 1106

REGISTERED
PROFESSIONAL
LAND SURVEYOR
William R. Wells
OREGON
JULY 22, 1977
WILLIAM R. WELLS
1106

Office of...County...Surveyor..... County of...Baker.....
State of...Oregon..... I hereby certify that the within instrument was filed in this office
for record on the...28... day of...Oct....., 1985
..... by
(COUNTY OFFICIAL) (DEPUTY)