


CERTIFIED RECORD OF LAND CORNER MONUMENTATION

History of original corner establishment:

This corner was originally established by Arthur Philbrick under Mineral Survey No. 477, during the survey of June and July 1902. The original notes state that at the corner a scribed tamarack post 4' long by 4" sq. was set 12" in the ground and surrounded with a mound of earth and stone from which:

- A 6" black pine bears S41°15'E-22.2'.
- A 6" black pine bears N32°40'W-25.62'.
- Both marked B.T.C.4-477.

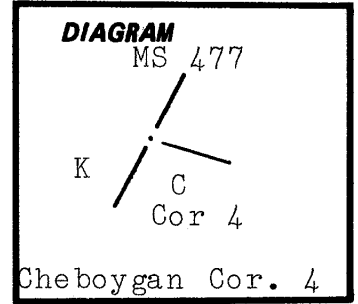

Description of corner evidence found:

Found the rotted remains of the original post at ground level in a mound of earth and stone from which:

- A dead and down, very rotten lodgepole pine bears S41½°E-23'± with not scribing visible (original bearing tree). This tree is too rotten to attach signs.
- An 8" dead, down lodgepole pine bears N32 ¾°W-26'± with visible scribing (original bearing tree).

Description of monument and accessories I established to perpetuate the original location of this corner:

Set a 2½" by 30" aluminum pipe with a 2½" aluminum cap 20" in the ground and surrounded with a mound of earth and stone from which:

- A 9" engleman spruce bears S36½°W-13.4' scribed 4-C-477 BT.
- An 8" alpine fir bears S79½°E-7.5' scribed 4-C-477 BT.
- New bearing trees have a brass washer stamped PLS 1106 nailed to face of blaze.
- Attached signs 54-3 and 54-9 to each bearing tree and painted face of blaze and a 6" red band around each bearing tree.
- Set steel fence posts on National Forest Boundary NE and SE of corner and attached sign 54-9 to one post and sign 54-2 to both posts.

Used steel tape and staff compass with 20°E declination, measured to the center of the bearing trees.

This corner was remonumented on August 14, 1985.

Witness: John Tuttle

Cap is marked;
MS 477
K
C
Cor 4
1985
PLS 1106

REGISTERED
PROFESSIONAL
LAND SURVEYOR

William R. Wells

OREGON
JULY 22, 1977
WILLIAM R. WELLS
1106

Office of...County...Surveyor..... County of...Baker.....
State of...Oregon....., I hereby certify that the within instrument was filed in this office
for record on the...8... day of...Oct....., 19...85
..... by
(COUNTY OFFICIAL) (DEPUTY)