


CERTIFIED RECORD OF LAND CORNER MONUMENTATION

History of original corner establishment:

The corner was originally established by Arthur Philbrick under Mineral Survey No. 477, during June and July 1902. The original notes state that at the corner a black pine post 4' long by 4" sq. was set 12" in the ground and surrounded with a mound of earth from which:
A 20" pine bears N34°45'W-18.8'.
A 6" white fir bears S4°50'W-5.6'.
Both marked B.T.F.N.C.-477.

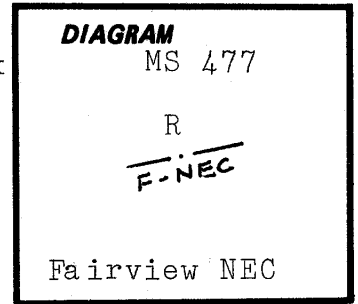

Description of corner evidence found:

Found a rotted post at the ground level from which:

A rotted lodgepole pine stump bears N34 3/4°W-18.8' with fragmentary scribing and measuring nail visible.

Description of monument and accessories I established to perpetuate the original location of this corner:

Set a 2 1/2" by 30" aluminum pipe with a 2 1/2" aluminum cap 20" in the ground and surrounded with a mound of earth and stone from which:

An 11" white fir bears S12 1/2°E-10.1' scribed NEC-F-477 BT.
A 10" engleman spruce bears S68°E-36.0' scribed NEC-F-477 BT.
New bearing trees have a brass washer stamped PLS 1106 nailed to face of blaze. Attached sign 54-3 and 54-9 to each bearing tree and painted face of blaze and a 6" red band around each bearing tree. Set steel fence post on claim line near corner and attached sign 54-9.

Used steel tape and staff compass with 20°E declination, measured to the center of the bearing trees.

Cap is marked:
MS 477



This corner was remonumented on August 8, 1985.

1985
PLS 1106

Witness: John Tuttle

REGISTERED
PROFESSIONAL
LAND SURVEYOR

William R. Wells

OREGON
JULY 22, 1977
WILLIAM R. WELLS
1106

Office of.....County Surveyor..... County of.....Baker.....
State of.....Oregon....., I hereby certify that the within instrument was filed in this office
for record on the...8... day of.....Oct....., 1985

..... by
(COUNTY OFFICIAL) (DEPUTY)

FILED _____
BAKER COUNTY SURVEYOR
SURVEY NO. 8-36-45
9-36-