


CERTIFIED RECORD OF LAND CORNER MONUMENTATION

Z-13

History of original corner establishment:

This corner was originally established by Otis Gould, U.S. Cadastral Surveyor, under special instructions dated Nov. 27, 1935, during his surveys in July through October, 1937. The original notes state that at the corner a 2" iron post, 3' long, was set 14" in the ground to bedrock and surrounded with a mound of stone to the top. The iron post has a marked brass cap. From the corner:

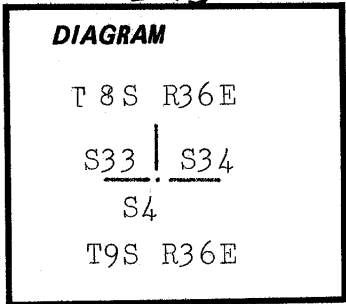

- A 13" fir bears N61 $\frac{1}{2}$ ° E-59 lks, marked T8S R36E S34 BT.
- A 10" fir bears N66° W-44 lks, marked T8S R36E S33 BT.

Description of corner evidence found:


- A 2 $\frac{1}{2}$ " brass cap on a 2" i.p. protruding 6" from a stone mound from which:
- A 21" white fir bears N64° E-38.9' with healed blaze.
- A 9" white fir bears N66° W-29.9' with scribing visible on a open blaze.

The monument has a flanged base.

Description of monument and accessories | established to perpetuate the original location of this corner:

Cleaned area around corner and shaped a mound of earth around the stone mound surrounding the monument. Painted face of blaze and a 6" red band around each bearing tree and attached sign 54-3 and 54-9. Set steel fence post East of corner and attached sign 54-9.

The cap is a standard GLO brass cap marked:

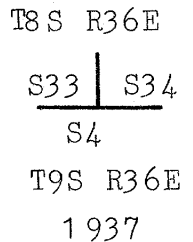

Used steel tape and staff compass with 20° E declination, measured to the center of the bearing trees.

This corner was maintained on September 18, 1985.

Witness: Bob English.

REGISTERED PROFESSIONAL LAND SURVEYOR
--

William R. Wells

OREGON JULY 22, 1977 WILLIAM R. WELLS 1106
--

Office of..... County Surveyor..... County of..... Baker.....
 State of..... Oregon....., I hereby certify that the within instrument was filed in this office
 for record on the..... day of....., 19.....
 by
 (COUNTY OFFICIAL) (DEPUTY)

FILED 2-12-86
 BAKER COUNTY SURVEYOR
 SURVEY NO. 8-36-49