


CERTIFIED RECORD OF LAND CORNER MONUMENTATION

Z-15

History of original corner establishment:

This corner was originally established by Otis Gould, U.S. Cadastral Surveyor, under special instructions dated Nov. 27, 1935, during his survey in July through October, 1937. The original notes state that at the corner a marked brass cap on a 1" by 3' long iron post was set 27" in the ground from which:

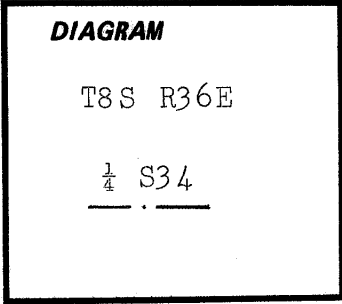

A 20" fir bears N62¹/₈°E-30 lks, marked 1/4 S34 BT.
A 14" fir bears N40°W-44 lks, marked 1/4 S34 BT.

Description of corner evidence found:

A 2¹/₂" brass cap on a 1" iron pipe protruding 4" from a earth mound from which:

A 20" standing dead spruce bears N62°E-20.5' with open blaze and visible scribing. Original notes call this tree a fir.
A 13" dead down spruce bears N40°W-29.0'± with scribing visible on an open blaze. Original notes call this tree a fir.

Description of monument and accessories established to perpetuate the original location of this corner:

Cleaned up area around the monument. From the monument:

A 19" white fir bears N51°E-42.0' scribed 1/4 S34 BT.
A 19" spruce bears N23°W-32.1' scribed 1/4 S34 BT.

New bearing trees have a brass washer stamped PLS 1106 nailed to the face of blaze. Attached sign 54-3 and 54-9 and painted face of blaze and a 6" red band around each bearing tree. Set steel fence post East of corner and attached sign 54-9.

Used steel tape and staff compass with 20°E declination, measured to the center of the bearing trees.

The cap is a standard GLO brass cap marked:

This corner was maintained on September 20, 1985.

Witness: Bob English.

1/4 S34
1937

**REGISTERED
PROFESSIONAL
LAND SURVEYOR**

William R. Wells

**OREGON
JULY 22, 1977
WILLIAM R. WELLS
1106**

Office of County Surveyor County of Baker
State of Oregon I hereby certify that the within instrument was filed in this office
for record on the..... day of....., 19.....
..... by

(COUNTY OFFICIAL)

(DEPUTY)

FILED 2-12-1986
BAKER COUNTY SURVEYOR
SURVEY NO. 8-36-50