


CERTIFIED RECORD OF LAND CORNER MONUMENTATION

INDEX MS 800

History of original corner establishment:

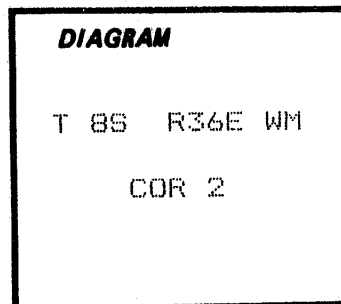

A. Ira L. Hoffman, U.S. Deputy Mineral Surveyor, under Mineral Survey No. 800 surveyed the Richard Woods claim known as Morning Star Lode from October 11, 1917 to September 19, 1918 and approved by the U.S. Surveyor General's Office 19 November, 1918. Otis O. Gould, U.S. Deputy Surveyor did a dependent resurvey under special instructions dated 27 Nov. 1935, and approved 17 August, 1939.

SURVEYOR GENERAL'S RECORD STATES: (Otis O. Gould)

Set an iron post, 3 ft. long, 1 in. diam., 27 ins. in the ground for Cor. No. 2 Morning Star lode, with brass cap marked: from which

- Description of corner evidence found:**
- A spruce 11 ins. diam. bears S73-30E., 16 lks. dist., marks grown over. (Old B.T.)
 - A fir, 8 ins. diam., bears S26-45E., 9 lks. dist., marks grown over. (Old B.T.)

2
MS
800
1937

B. MONUMENT FOUND:

I found a 2.5" dia. brass cap on a 1.0" dia. iron pipe 14" exposed in mine tailings. The pipe was leaning north with rotted wood post remnants along the SW side to base. Cap marked: U S GENERAL LAND OFFICE SURVEY PENALTY \$250 FOR REMOVAL

ACCESSORIES FOUND:

Dead and down rotted remains of fir with visible scribing on tailings pile 13" Spruce bears S73-30E, 10.1 ft. partially healed blaze and scribing

Description of monument and accessories established to perpetuate the original location of this corner:

CORNER WORK DONE ON 6/8/90

C. I carefully dug out south side of monument to its base and plumbed to vertical without disturbing base. Backfilled and tamped to 12" exposed. Built rock mound to top; leveled mine tailings on south side. NEW ACCESSORIES ESTABLISHED

- A Spruce, 13" dia. bears S70E, 10.9 ft.; scribed COR 2 MS 800 BT
- A Spruce, 11" dia. bears S44W, 29.2 ft., scribed COR 2 MS 800 BT

Painted the blaze red on each BT
 Painted a 6" wide red band around each BT
 Placed brass washer marked "PLS 2060" at base of each BT blaze
 Placed metal sign with bearing and distance information on each BT (54-3)
 Placed metal ATTENTION sign on each BT (54-4)
 Placed 6 ft. steel fence post at corner with metal PROPERTY BOUNDARY sign and metal ATTENTION sign (54-2 and 54-4) attached
 I measured to the centerline of each bearing tree using tape and hand compass with declination set at 20 degrees east.

REGISTERED PROFESSIONAL LAND SURVEYOR
<i>Edwin A. Stryker</i>
OREGON JULY 15, 1983 EDWIN A. STRYKER 2060

Office of..... County of.....
 State of....., I hereby certify that the within instrument was filed in this office
 for record on the..... day of....., 19.....
 by..... (DEPUTY)
 (COUNTY OFFICIAL)

FILED 11-16-1990
 BAKER COUNTY SURVEYOR
 SURVEY NO. 8-36-55