


CERTIFIED RECORD OF LAND CORNER MONUMENTATION

INDEX MS 813

History of original corner establishment:

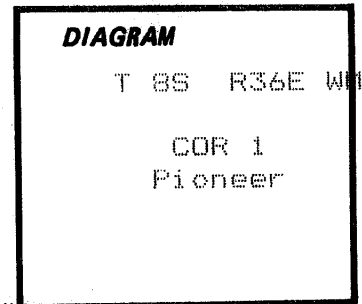

A. William W. Elmer, U.S. Deputy Mineral Surveyor, under Mineral Survey No. 813 surveyed the Elizabeth Dahl claim known as Pioneer, Pacific, and LaCross Lodes from 28 June, to 8 July, 1922 and approved by the U.S. Surveyor General's Office.

SURVEYOR GENERAL'S RECORD STATES:***CONT. NEXT PAGE**

Identical with Cor. No. 3, Sur. No. 485, Gold Hill lode, claimants Peter D. Estes and Joseph D. Young. A post 4 ins. square, 3.5 ft. long, decayed at the bottom was found lying beside a mound of earth and stone, scribed GH 3 485, which I replaced with a new pine post, 4 ins. square, 4 ft. long, set 1.5 ft. in the ground, in the center of the original mound of earth and stone and scribed GH 3 485 1 813 PIONEER

Description of corner evidence found:

B. MONUMENT FOUND:

I found a stone mound with remains of scribed wood post on surface with scribing of "H 3 485". Found a 6"x4"x5" rotted pointed remnant of post 19" below surface.


ACCESSORIES FOUND:

22" dia. Grand Fir bears N62E, 14.2 ft. with healed blaze. (did not open)
21" dia. Grand Fir bears N77E, 15.9 ft. with healed blaze. (did not open)

Description of monument and accessories I established to perpetuate the original location of this corner:

CORNER WORK DONE ON 6/19/90

C. At the position of the pointed post remnant, set a 2.5" dia. by 30" long aluminum pipe with a 2.5" dia. aluminum cap. The pipe is set 19" in the ground on bedrock at point of post remains. Mounded earth and stone to 1" of top. Cap is marked

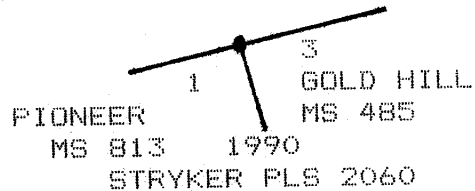

NEW ACCESSORIES ESTABLISHED

13" dia. Grand Fir bears S66W, 15.2 ft.; scribed 1 MS 813 PIONEER BT
GH 3 MS 485

Painted the blaze red on each BT
Painted a 6" wide red band around each BT
Placed brass washer marked "PLS 2060" at base of each BT blaze
Placed metal sign with bearing and distance information on each BT (54-3)
Placed metal ATTENTION sign on each BT (54-4)
Placed 6 ft. metal guard post at corner with metal PROPERTY BOUNDARY sign and metal ATTENTION sign (54-2 and 54-4)
I measured to the centerline of each bearing tree using tape and hand compass with declination set at 20 degrees east.

REGISTERED PROFESSIONAL LAND SURVEYOR

Edwin A. Stryker

OREGON
JULY 15, 1988
EDWIN A. STRYKER
2060

Office of..... County of.....
State of....., I hereby certify that the within instrument was filed in this office
for record on the..... day of....., 19.....
..... by

(COUNTY OFFICIAL)

(DEPUTY)