

CERTIFIED RECORD OF LAND CORNER MONUMENTATION


History of original corner establishment:

Corner originally established by John Hagel under Mineral Survey No.427 and surveyed under instructions dated July 8, 1901.

Original notes state:

Set a white fir post 4 ins.square, 4½ ft.long, 18 ins. in the ground, with a mound of earth around it, scribed Alta Q. Cl.,C.3-427.

A red fir tree, 4 ins.diam.,bears S88°45'E, 11.8 ft.
A red fir tree 4 ins.diam.,bears N24°E, 1.2 ft.;
both blazed and scribed Alta,C.3-427-BT.

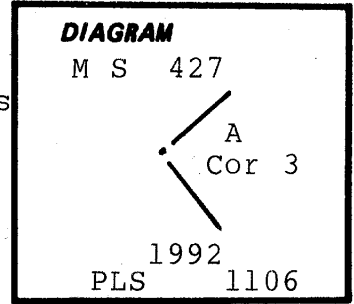

Description of corner evidence found:

Found a 12" segment of original post below ground level, from which...

A green 15" douglas fir brs S85½°E, 11.8' with healed blaze. (Original BT)

A 14" dead uprooted douglas fir brs N24°E, 1.2' to root hole, with healed blaze.

Description of monument and accessories established to perpetuate the original location of this corner:

At position of found post...

Set 2½" x 30" aluminum pipe with 2½" aluminum cap 24" in ground and surrounded with a mound of earth and stone. Cap marked as shown in corner diagram. Placed wood post remains on mound.

New bearing trees established:

A 22" western larch brs S19¼°W, 93.7' scribed 3-A-427 BT.

A 22" ponderosa pine brs S06°E, 118.9' scribed 3-A-427 BT.

New bearing trees have a brass washer stamped PLS 1106 nailed to face of blaze.Attached sign 54-3 & 54-9 to each BT & painted face of blaze & 6" red band around each BT. Set steel fence post on National Forest Boundary NE of corner with sign 54-2 & 54-9 attached.

Compass declination 18° East.

I hereby certify that the above corner was properly remonumented by me to U.S.F.S. standards on September 10,1992.

REGISTERED
PROFESSIONAL
LAND SURVEYOR

William R. Wells

OREGON
JULY 22, 1977
WILLIAM R. WELLS
1106

Office of.....County Surveyor..... County of Baker.....

State of.....Oregon....., I hereby certify that the within instrument was filed in this office

for record on the..... day of....., 19.....

..... by

(COUNTY OFFICIAL)

(DEPUTY)

FILED 3-24-93

BAKER COUNTY SURVEYOR

SURVEY NO. 8-36-70