

CERTIFIED RECORD OF LAND CORNER MONUMENTATION


**History of original corner establishment:**

Corner originally established by John Hagel under Mineral Survey No.427 and surveyed under instructions dated July 8, 1901.

Original notes state:

Set a white fir post 4 ins.square, 4½ ft.long, 18 ins. in the ground, with a mound of rocks around it, scribed Alta Q.Cl.,C.4-427.

A white fir tree 5 ins.diam.bears N.28°W, 20.8 ft.  
A white fir tree 8 ins.diam.bears S65°W, 35.6 ft.:  
both blazed and scribed Alta Q.Cl.,C.4-427-B.T.

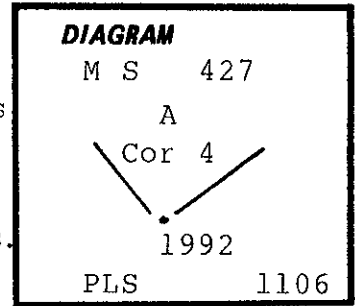

Alta Cor.4

**Description of corner evidence found:**

Found no trace of original post.

A 14" white fir brs N29½°W, 20.8' to blaze face & 20.9' to center with previously opened but not healed blaze.(Original BT)  
A 20" white fir brs S63½°W, 35.6' to blaze face & 35.9' to center with healed blaze.(Original BT)

**Description of monument and accessories I established to perpetuate the original location of this corner:**

Re-established corner by intersecting record distances, measuring from original blaze face, from which...

Set 2½" x 30" aluminum pipe with 2½" aluminum cap 28" in ground and surrounded with a mound of earth and stone. Cap marked as shown in corner diagram.

New bearing tree established:

A 14" western larch brs S27½°W, 51.2' scribed 4-A-427 BT.  
Other accessory: "XBO" chiseled in the East face of a 8'x6'x3½' out of ground granite rock, brs S80½°W, 42.4'.

New bearing tree has a brass washer stamped PLS 1106 nailed to face of blaze. Painted face of blaze and a 6" red band around BT. Measured to "X" on the bearing object markings. Painted "XBO" marking on bearing object red. Placed sign 54-3 & 54-9 on BT and bearing object. Set steel fence post NE of corner on National Forest Boundary and attached sign 54-2 7 54-9.

Compass declination 18° East.

I hereby certify that the above corner was properly re-established by me to U.S.F.S. standards on September 15, 1992.

REGISTERED  
PROFESSIONAL  
LAND SURVEYOR

*William R. Wells*

OREGON  
JULY 27, 1927  
WILLIAM R. WELLS  
1106

Office of...County Surveyor..... County of...Baker.....  
State of...Oregon....., I hereby certify that the within instrument was filed in this office  
for record on the..... day of....., 19.....  
..... by .....  
(COUNTY OFFICIAL) (DEPUTY)