

CERTIFIED RECORD OF LAND CORNER MONUMENTATION

History of original corner establishment:


Corner originally established by John Hagel under Mineral Survey No.427 and surveyed under instructions dated July 8, 1901.

Original notes state:

Set a black pine post 4 ins. square, 4½ ft. long, 18 ins.in the ground, with a mound of earth around it, scribed Alta Q. Cl.,C.8-427.

A black pine tree, 3 ins.diam. bears N. 13.6 ft.

A black pine tree, 4 ins.diam. bears N12°50'W.,25.7 ft.: both blazed and scribed Alta Q.Cl.,C.8-427-BT.

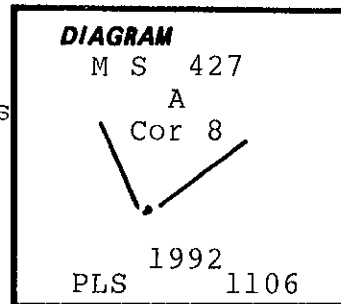

Cor.8 Alta

Description of corner evidence found:

Found post hole and rotted post remains below ground surface from which...

A 8" dead, down lodgepole pine brs N12 3/4°W, 25.7'± to root hole with scribes visible on partially healed blaze. (Original BT)

Description of monument and accessories I established to perpetuate the original location of this corner:

At position of found post remains...

Set 2½" x 30" aluminum pipe with 2½" aluminum cap 24" in ground and surrounded with a mound of earth and stone. Cap marked as shown in corner diagram.

New bearing trees established:

A 14" western larch brs S0½°W, 33.6' scribed 8-A-427 BT.

A 14" western larch brs S82½°W, 20.7' scribed 8-A-427 BT.

New bearing trees have a brass washer stamped PLS 1106 nailed to face of blaze. Attached sign 54-3 & 54-9 to each BT & painted face of blaze & 6" red band around each BT. Set steel fence post on National Forest Boundary NE of corner with sign 54-2 & 54-9 attached.

Compass declination 18° East.

I hereby certify that the above corner was properly remonumented by me to U.S.F.S. standards on September 10, 1992.

REGISTERED
PROFESSIONAL
LAND SURVEYOR

Will R. Wells

OREGON
JULY 22, 19 /
WILLIAM R. WELLS
1106

Office of..... County Surveyor..... County of..... Baker.....

State of..... Oregon....., I hereby certify that the within instrument was filed in this office

for record on the..... day of....., 19.....

..... by

(COUNTY OFFICIAL)

(DEPUTY)

FILED 3-24-93

BAKER COUNTY SURVEYOR

SURVEY NO. 8-36-75