

CERTIFIED RECORD OF LAND CORNER MONUMENTATION

History of original corner establishment:


This corner was originally established by Arthur Philbrick under Mineral Survey No. 481, the position of this corner was Amended in May, 1904, by Arthur B. Browne under Amended Mineral Survey No. 481.

Browne's original notes state:

A post 6 in. sq. 4 ft. long, set 1 ft. in the ground with a mound of earth and stone, scribed RF. 1-481.

A red fir tree 6 in. in diameter blazed and scribed B.T.R.F. 1-481, bears S18°8'E, 18.3 ft.

A red fir tree 35 in. in diameter blazed and scribed B.T.R.F. 1-481, bears N53°54'W, 42.36 ft.

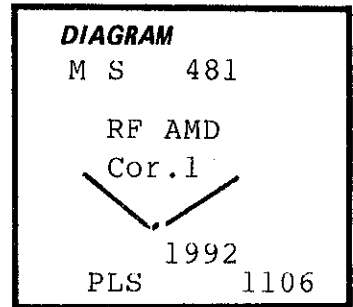

1-RED FOX AMD

Description of corner evidence found:

Found rotted post remains below ground level, from which,

A 42" sawn douglas fir stump brs N35½°W, 43.9' (Record: 53°54'-the 3 & 5 are switched) with bottom of blaze and catface visible. (Original BT)

A 23" white fir brs S18¼°E, 18.8' with healed blaze. (Original BT)

Description of monument and accessories I established to perpetuate the original location of this corner:

At position of found post remains...

Set 2½" x 30" aluminum pipe with 2½" aluminum cap 26" in ground and surrounded with a mound of earth and stone. Cap marked as shown in corner diagram.

New bearing trees established:

A 29" ponderosa pine brs S54¼°W, 53.0' scribed 1-RF AMD-481 BT.

A 21" ponderosa pine brs S80½°W, 99.8' scribed 1-RF AMD-481 BT.

New bearing trees have a brass washer stamped PLS 1106 nailed to face of blaze. Attached sign 54-3 & 54-9 to each BT & painted face of blaze & 6" red band around each BT. Set steel fence post on National Forest Boundary NE of corner with sign 54-2 & 54-9 attached.

Compass declination 18° East.

I hereby certify that the above corner was properly remonumented by me to U.S.F.S. standards on September 15, 1992.

REGISTERED
PROFESSIONAL
LAND SURVEYOR

William R. Wells

OREGON
JULY 22, 1977
WILLIAM R. WELLS
1106

Office of... County Surveyor County of... Baker

State of... Oregon, I hereby certify that the within instrument was filed in this office

for record on the..... day of....., 19.....

..... by

(COUNTY OFFICIAL)

(DEPUTY)