

CERTIFIED RECORD OF LAND CORNER MONUMENTATION

**History of original corner establishment:**

Corner originally established by Arthur Philbrick under Mineral Survey No.481 and dated July 11, 1902.

**Original notes state:**

A red fir post, 4 ft. long, 4 ins. square, set 12 ins. in the ground, with mound of earth, scribed R.F.C.W.-481 whence:

A red fir, 15 ins. diam, bears S47°25'E, 30.70 ft., blazed and scribed B.T.R.F.W.C.-481.


In May, 1904, this survey was amended by Arthur B. Browne. Original notes state:

Corner No.2, a post marked R.F.2-481W.C., identical with W. center end post of original survey, and identical with discovery point. A red fir tree 15 in. in diameter blazed and scribed B.T.R.F.2-481W.C. bears S47°25'E, 30.7 ft. A red fir tree 20 in. in diameter marked B.T.R.F.2-481W.C. bears N80°W 1.5 ft. This corner was later used as the East Center post of MS 485, Gold Hill.

**Description of corner evidence found:**

Found rotted post remains below ground level, from which:

A 20",3'high broken off douglas fir brs S47½°E,31.6', with slab of wood and scribing visible lying beside tree. (Original BT)

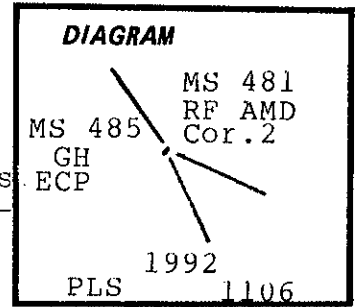

Cor.2 Red Fox Amd.MS 481 ECP, Gold Hill, MS 485

**Description of monument and accessories | established to perpetuate the original location of this corner:**

At position of rotted post remains...

Set 2½" x 30" aluminum pipe with 2½" aluminum cap 28" in ground and surrounded with a mound of earth and stone. Cap marked as shown in corner diagram. Placed post remains on new mound.

**New bearing trees established:**

A 20" white fir brs S18°W, 40.7' scribed 2-RF AMD-481/ECP-GH-485 BT.

A 17" white fir brs S54½°W, 25.7' scribed 2-RF AMD-481/ECP-GH-485 BT.

New bearing trees have a brass washer stamped PLS 1106 nailed to face of blaze. Attached sign 54-3 & 54-9 to each BT & painted face of blaze & 6" red band around each BT. Set steel fence post on National Forest Boundary SE of corner with sign 54-2 & 54-9 attached.

Compass declination 18° East.

I hereby certify that the above corner was properly remonumented by me to U.S.F.S. standards on September 15, 1992.

REGISTERED  
PROFESSIONAL  
LAND SURVEYOR

*William R. Wells*

OREGON  
JULY 22, 1977  
WILLIAM R. WELLS  
1106

Office of...County Surveyor..... County of...Baker.....

State of...Oregon....., I hereby certify that the within instrument was filed in this office

for record on the..... day of....., 19.....

..... by .....  
(COUNTY OFFICIAL) (DEPUTY)