

CERTIFIED RECORD OF LAND CORNER MONUMENTATION

History of original corner establishment:


Corner originally established by Charles M. Foster under Mineral Survey No. 505, surveyed under instructions dated April 5, 1904.

Original notes state:

A pine post 4 ft long, 4 ins square set 18 ins in the ground, surrounded with a mound of earth, scribed C-1-505, from which,

A pine 6 ins in diam bears N62°10'W, 11.0 ft dist blazed & scribed C-1-505-B.T.

A fir 10 ins in diam bears S7°45'E, 25.9 ft dist blazed & scribed C-1-505-B.T.

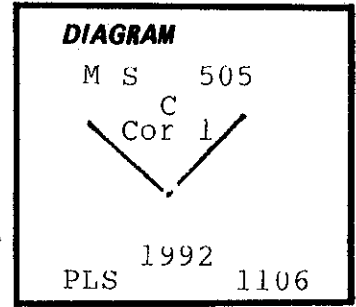

CASAUBON Cor. 1

Description of corner evidence found:

Found rotted post remains at ground level in small stone mound from which:

A 8" dead standing lodgepole pine brs N61½°W, 12.0' with scribing visible on partially healed blaze. (Original BT)

A 21" white fir brs S06½°E, 26.3' with scribing visible on partially healed blaze. (Original BT)

Description of monument and accessories established to perpetuate the original location of this corner:

At position of found post remains in the stone mound...

Set 2½" x 30" aluminum pipe with 2½" aluminum cap 26" in ground and surrounded with a mound of earth and stone. Cap marked as shown in corner diagram.

New bearing trees established:

A 12" western larch brs S76½°W, 25.1' scribed 1-C-505 BT.

A 15" western larch brs S23½°W, 72.1' scribed 1-C-505 BT.

New bearing trees have a brass washer stamped PLS 1106 nailed to face of blaze. Attached sign 54-3 & 54-9 to each BT & painted face of blaze & 6" red band around each BT. Set steel fence post on NE claim line and attached sign 54-9.

Compass declination 18° East.

I hereby certify that the above corner was properly remonumented by me to U.S.F.S. standards on September 17, 1992.

REGISTERED
PROFESSIONAL
LAND SURVEYOR

Willie R. Wells

CASAUBON
CORNER
WILLIE R. WELLS
1106

Office of... County Surveyor..... County of... Baker
State of... Oregon....., I hereby certify that the within instrument was filed in this office
for record on the..... day of....., 19.....

..... by
(COUNTY OFFICIAL) (DEPUTY)

FILED 3-24-93

BAKER COUNTY SURVEYOR

SURVEY NO. 8-36-84