

CERTIFIED RECORD OF LAND CORNER MONUMENTATION

**History of original corner establishment:**


Corner originally established by Charles M. Foster under Mineral Survey No. 505, surveyed under instructions dated April 5, 1904.

Original notes state:

A pine post 4 ft long, 4 ins square, set 18 ins in the ground surrounded with a mound of earth & stone, scribed C-4-505, from which,

A fir 8 ins in diam bears North 23 ft dist, blazed & scribed C-4-505-B.T.

A fir 6 ins in diam bears S73°20'W, 25 ft dist, blazed & scribed C-4-505-B.T.

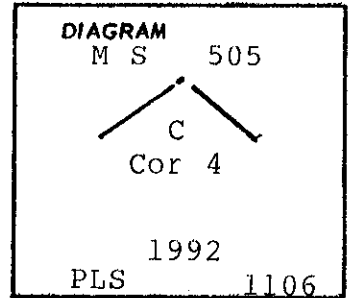

Casaubon Cor.4

**Description of corner evidence found:**

Found rotted post remains in mound of stone, from which,

A 10" dead standing white fir brs North 23.4' with scribes visible on partially healed blaze.

A 13" dead, standing white fir brs S73½°W, 25.1' with scribes visible on partially healed blaze.

**Description of monument and accessories established to perpetuate the original location of this corner**

At position of found post remains...

Set 2½" x 30" aluminum pipe with 2½" aluminum cap 26" in ground and surrounded with a mound of earth and stone. Cap marked as shown in corner diagram.

New bearing trees established:

A 12" lodgepole pine brs S23½°E, 43.0' scribed 4-C-505 BT.

A 16" white fir brs N41½°W, 26.8' scribed 4-C-505 BT.

New bearing trees have a brass washer stamped PLS 1106 nailed to face of blaze. Attached sign 54-3 & 54-9 to each BT & painted face of blaze & 6" red band around each BT. Set steel fence post on National Forest Boundary SE of corner with sign 54-2 & 54-9 attached.

Compass declination 18° East.

I hereby certify that the above corner was properly remonumented by me to U.S.F.S. standards on September 11, 1992.

REGISTERED  
PROFESSIONAL  
LAND SURVEYOR

*William R. Wells*

OREGON  
JULY 22, 1977  
WILLIAM R. WELLS  
1106

Office of County Surveyor ..... County of Baker .....  
State of Oregon ..... , I hereby certify that the within Instrument was filed in this office  
for record on the ..... day of .....  
..... by .....  
(COUNTY OFFICIAL) (DEPUTY)

FILED 3-24-93  
BAKER COUNTY SURVEYOR  
SURVEY NO. 8-36-87