

RECORD OF LAND CORNER MONUMENTATION

CORNER #2 EUREKA PLACER CLAIM, MINERAL SURVEY 194,
IDENTICAL WITH CORNER #1 VICTOR PLACER CLAIM, MINERAL SURVEY 194,
SITUATED IN SECTION 33, T. 8 S., R. 37 E., W.M.
PAGE 1 OF 2


ORIGINALLY ESTABLISHED BY: Emil F. Voigt, U.S. Deputy Mineral Surveyor

MINERAL SURVEY NUMBER: 194

COMPLETION DATE: April 20, 1889

SUBSEQUENT SURVEYS:

- ▶ G.L.O. Retracement by Lincoln E. Wilkes, U.S. Cadastral Engineer, under Group No. 107, Approved May 26, 1927
- ▶ Unrecorded remonumentation by John R. Mitchell, an unlicensed Survey Technician, as documented on U.S. Forest Service corner card dated 9/30/1980
- ▶ Survey by Leland L. Myers, PLS #699, filed June 23, 2016 as Survey No. 8-37-136 in the Baker County Surveyor's office

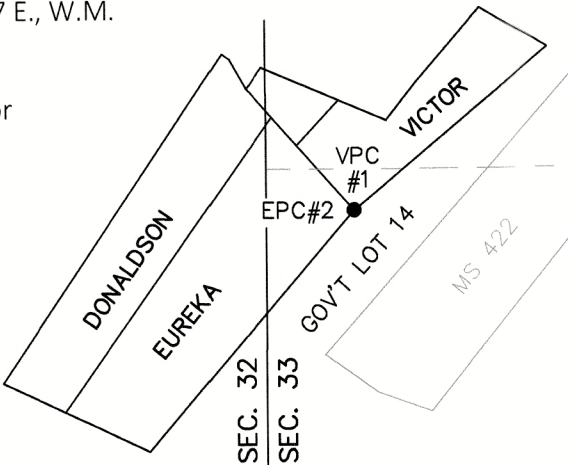

ORIGINAL DESCRIPTION: A blk pine post 5 ft long 4 1/2" square 12" in the ground with mound of stone around it marked Cor No. 1 VPC. a tamarack 30" Dia blazed and marked Cor 1 VPC bears N.73°25'E. 16L dist (10.6 ft.)

G.L.O. DESCRIPTION: To cor. No. 2, common with cor. No. 1, Victor Claim, same survey, as determined by reference to the stump of the bearing tree, described as "A tamarack, 30 ins. dia., bears N.73°25'E., 16 lks. dist. marked C O R N 2 E P - 1 4 B T. I find no trace of mound of stone, or original post. Agreeing with the bearing tree, I set an iron pipe 1 1/4 ins. dia., 4 1/2 ft. long, 3 1/2 ft. in the ground.

MITCHELL'S 1981 DESCRIPTION:

DESCRIBE CORNER MONUMENT FOUND: Md of stone

DESCRIBE BEARING TREES OR OTHER OFFICIAL ACCESSORIES FOUND: 26" W.L. Stump brs N68°E w/ full scribing

MONUMENT: DESCRIBE NEW MONUMENT SET, OR WORK DONE TO PRESERVE EXISTING MONUMENT: Set 2 1/2" B.C. on 22" x 1" gal. pipe 24" deep in original hole in md of stone Marked EPC C2 MS 194 1980

ACCESSORIES: DESCRIBE NEW BT'S WITNESS OBJECTS ETC. ESTABLISHED, OR WORK DONE TO PRESERVE EXISTING EVIDENCE: 16" WL brs N20°W 2 lks marked EPC 2 MS 194 BT; 11" WF brs S58°E 4 lks marked EPC 2 MS 194 BT

This cor. on line 6x7 of EPCC & is not an angle pt of the consolidated survey


MYER'S 2016 SURVEY:

Myers found and accepted Mitchell's brass cap monument for the corner

EVIDENCE FOUND: Found Mitchell's unrecorded monument, which is a 1 1/2" galvanized iron pipe with a 2 1/2" brass cap, marked as shown below, projecting 6" from a 3 ft. diameter mound of stone. I also found a 1 1/2" iron pipe, of unknown origin, set northeast and alongside Mitchell's brass cap monument. I believe the pipe was set sometime after Mitchell's 1981 remonumentation, as Mitchell makes no mention of it in his description of the found evidence. From the found brass cap monument, I found the following bearing trees:

- ▶ A western larch stump, 30" diameter, 1 ft. tall, with lower portion of blaze, bears N.71°E., 10.5 ft. (original BT)
- ▶ A western larch, 18" dbh, bears N.10°W., 1.62 ft. (Mitchell BT)
- ▶ A rootwad hole, bears S.60°E., 2.6 ft., with an 8" diameter dead and down white fir laying alongside, with partially healed blaze and visible scribing (Mitchell BT)


FOUND MONUMENT MARKED:

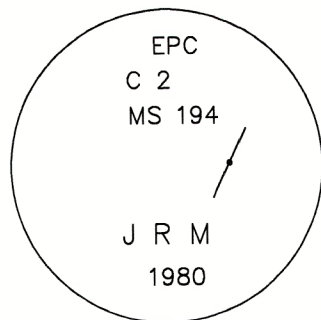

FILED October 24, 2024
BAKER COUNTY SURVEYOR
SURVEY NO. 8-37-191

RECORD OF LAND CORNER MONUMENTATION

CORNER #2 EUREKA PLACER CLAIM, MINERAL SURVEY 194,
IDENTICAL WITH CORNER #1 VICTOR PLACER CLAIM, MINERAL SURVEY 194,
SITUATED IN SECTION 33, T. 8 S., R. 37 E., W.M.
PAGE 2 OF 2

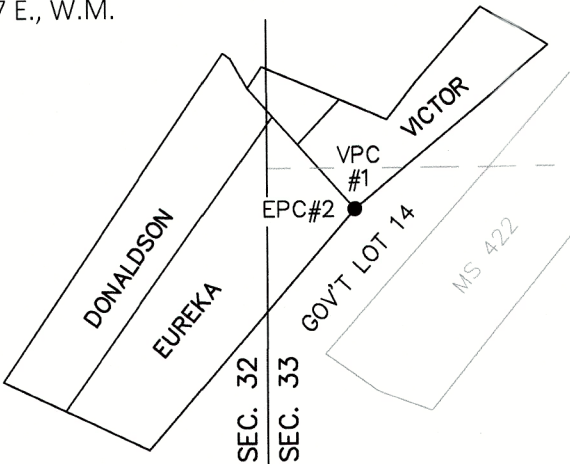

DESCRIPTION OF MONUMENTS AND ACCESSORIES SET AND METHODS USED:

I accept Mitchell's brass cap monument as a faithful and accurate perpetuation of the original corner, being harmoniously related to the original accessory evidence, and also to other found accepted corners of Mineral Survey 194 based on the G.L.O. record.


I dug down 12" below grade and cut off the found unrecorded iron pipe. I removed Mitchell's monument, and in it's place I set a standard USFS 2 1/2" x 30" aluminum pipe with attached 3 1/4" aluminum cap, 24" in the ground. Built a 3 ft. diameter mound of stone to top. Cap is marked as shown below. I cut Mitchell's monument in half, and deposited it along with the unrecorded pipe in the mound.

From which, I SET A NEW REFERENCE POINT:

- A 5/8"x 24" iron pin, bears N.59°26'E., 23.88 ft., with attached 2" aluminum cap marked *RP 1 2023 PLS 69454*

Placed a blue plastic-encased magnet at the base of the aluminum pipe. Painted a 6 inch red band around the live bearing tree, painted the healed blaze red, and attached new USFS 54-3 and 54-9 signs. Distance to live bearing tree measured to a Mag Spike driven in the side-center-right at the base of the tree, with an attached 1 1/2" aluminum washer stamped *PLS 69454*. Distance to original bearing tree stump measured to face of blaze. Bearings are geodetic, derived by GPS observation at the corner. Set an aluminum guard post N.50°E., 5 ft., with USFS signs 54-2 and 54-9 attached, and set another one S.41°W., 8 ft., with USFS sign 54-2 attached. See associated Map of Survey dated September 19, 2024 for survey-related information.

NEW CORNER MONUMENT MARKED:

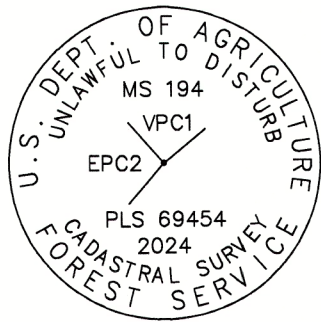


RESTORATION BY, STAMP AND DATE:

Work performed July 29, 2024
Survey completed September 19, 2024

Jason L. Hatfield, PLS
Spencer B. Jones, Survey Tech

USDA FOREST SERVICE
NORTHEAST OREGON LAND ZONE
1550 Dewey Avenue, Suite A
Baker City, OR 97814
(541) 523-1283

FILED October 24, 2024
BAKER COUNTY SURVEYOR
SURVEY NO. 8-37-191

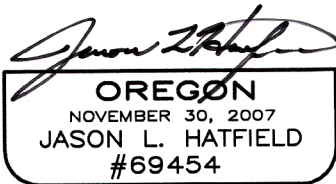

EXPIRES: 6/30/2025