

RECORD OF LAND CORNER MONUMENTATION

CORNER #6 EUREKA CONSOLIDATED PLACER CLAIM, MINERAL SURVEY 194,
IDENTICAL WITH CORNER #2 VICTOR PLACER CLAIM, MINERAL SURVEY 194,
SITUATED IN SECTION 33, T. 8 S., R. 37 E., W.M.


ORIGINALLY ESTABLISHED BY: Emil F. Voigt, U.S. Deputy Mineral Surveyor

MINERAL SURVEY NUMBER: 194

COMPLETION DATE: April 20, 1889

SUBSEQUENT SURVEYS:

- G.L.O. Retracement by Lincoln E. Wilkes, U.S. Cadastral Engineer, under Group No. 107, Approved May 26, 1927
- Survey by Leland L. Myers, PLS #699, filed June 23, 2016 as Survey No. 8-37-136 in the Baker County Surveyor's office

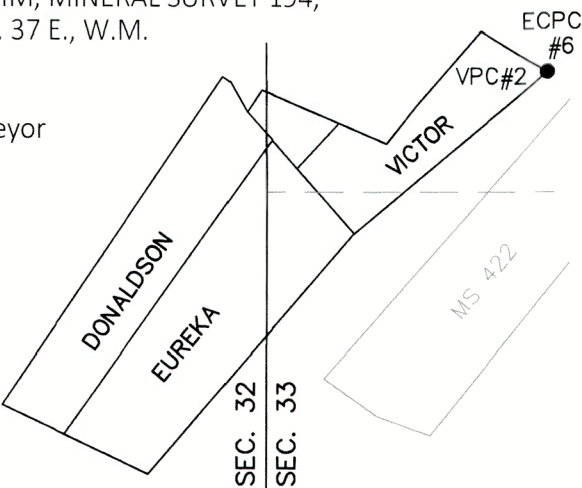

ORIGINAL DESCRIPTION: To Cor No. 6 identical with corner No. 2 Victor claim.....set a black pine post 5 ft long 4 1/2" square 12" in the ground with mound of stone around it marked it Cor 6 E C P C S N 1 9 4.
a spruce 28" Dia blazed and marked Cor No 6 ECPC SN 194 BT, bears N.35°W. 38L dist. (25.1 ft.)
a black pine 8" Dia, blazed and marked Cor No 6 ECPC SN 194 BT, bears S.28°30'E., 13L dist. (8.6 ft.)

G.L.O. DESCRIPTION: To cor. No. 2, which is a post as described, bears S.50°45'E., 3.73 chs. dist., from which
A black pine, 12 ins. dia., bears S.28 1/2°W., 13 lks. dist., marked E C P C S N 194 BT.
A white fir stump, 28 ins. dia., bears N.23°E., 38 lks. dist., Nearly all marks have been taken away.
I raise a mound of stone, 2 ft. base, 1 1/2 ft. high around the cor. post.

MYER'S 2016 SURVEY:

Note next to corner on plat states: "Found rock mound and one original Bearing Tree in good condition with visible scribing". Symbol at corner point indicates that Myers set a No. 5 rebar with yellow plastic cap marked PLS 699.

EVIDENCE FOUND: Found a 5/8" rebar with no cap, projecting 5" above ground in a 2 ft. diameter mound of stone. From which, the original southeast bearing tree, which is a lodgepole pine snag, 16" dbh, bears S.30°W., 8.41 ft., with scribe marks COR N6 ECP MSN 194 visible in a partially healed blaze. Distance was measured to a galvanized 20d nail found driven in the side-center-right at the base of the tree, with a 1 1/2" diameter aluminum washer marked PLS 699 attached. I searched for but found no trace of the second bearing tree. I accept the position of the found rebar for the original corner.

DESCRIPTION OF MONUMENTS AND ACCESSORIES SET AND METHODS USED:

I drove the rebar below grade, and set a standard USFS 2 1/2" x 30" aluminum pipe with attached 3 1/4" aluminum cap, 22" in the ground, over the top of the rebar. Raised a 3 ft. diameter mound of stone to base of cap. Cap is marked as shown.

From which, I SCRIBE NEW BEARING TREES:

- A Douglas-fir, 12" dbh, bears N.38°E., 27.84 ft. marked ECPC 6 - 194 in upper blaze, and XBT in lower blaze.
- A white fir, 8" dbh, bears N.13°W., 13.42 ft. marked X in upper blaze, and BT in lower blaze.

Painted a 6 inch red band around the bearing trees, and also painted the blazes red, and attached USFS 54-3 and 54-9 signs. Distances to new bearing trees measured to a Mag Spike driven in the side-center-right at the root crown of each tree, with an attached 1 1/2" aluminum washer stamped PLS 69454. Used a magnetic compass with 14° East declination to measure bearings to BT's. See associated Map of Survey dated September 19, 2024 for survey-related information.

RESTORATION BY, STAMP AND DATE:

Work performed July 29, 2024
Survey completed September 19, 2024

Jason L. Hatfield, PLS
Spencer B. Jones, Survey Tech

USDA FOREST SERVICE
NORTHEAST OREGON LAND ZONE
1550 Dewey Avenue, Suite A
Baker City, OR 97814
(541) 523-1283

FILED October 24, 2024
BAKER COUNTY SURVEYOR
SURVEY NO. 8-37-192

CORNER MONUMENT
MARKED:

