


RECORD OF LAND CORNER MONUMENTATION

INTERSECTION OF SOUTHEASTERLY LINE OF EUREKA PLACER CLAIM, MINERAL SURVEY 194,
WITH THE WEST LINE SECTION 33, T.8S., R.37E., W.M.

ORIGINALLY ESTABLISHED BY: CORNER NOT PREVIOUSLY ESTABLISHED

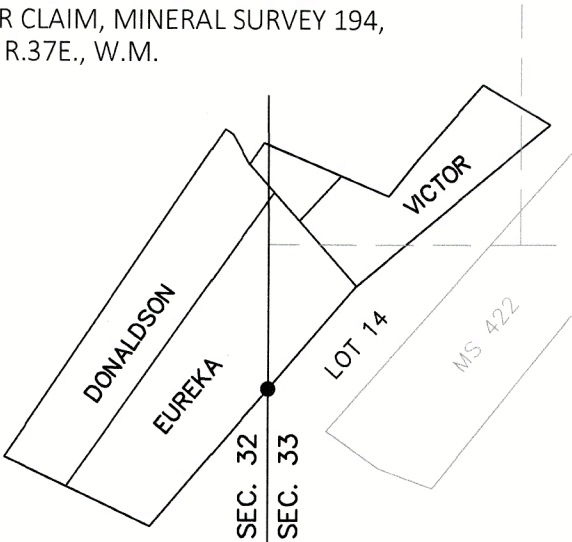

ORIGINAL DESCRIPTION: N/A

EVIDENCE FOUND: N/A

DESCRIPTION OF MONUMENTS AND ACCESSORIES SET AND METHODS USED:

At the intersection point, as determined by survey, I set a standard USFS 2 1/2" x 30" aluminum pipe with attached 3 1/4" aluminum cap, 12" to bedrock. Built a mound of stone around the monument, 3 ft. diameter base, 14" tall. Cap is marked as shown below.


From which, I SCRIBE A NEW BEARING TREE:

- A western larch, 13" dbh, bears S.24°E., 16.72 ft. marked X in upper blaze, and BT in lower blaze.

I also SET A NEW REFERENCE POINT:

- A 5/8"x 24" iron pin, bears S.22°W., 24.41ft., with attached 2" aluminum cap marked RP 1 2024 PLS 69454

CORNER MONUMENT
MARKED:

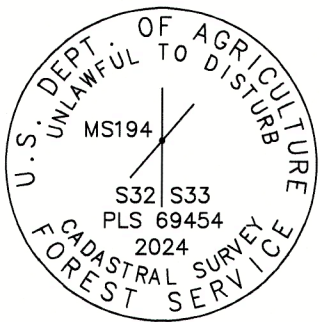

Placed a plastic-encased magnet at the base of the aluminum pipe. Painted a 6 inch red band around the bearing tree, and also painted the blazes red, and attached USFS 54-3 and 54-9 signs. Distance to bearing tree measured to a Mag Spike driven in the side-center-right at the root crown of the tree, with an attached 1 1/2 " aluminum washer stamped PLS 69454. Used a hand-held EDM to measure distances to accessories, and used a magnetic compass with 14° East declination to measure bearings to accessories. Set an aluminum guard post N.41°E., 3 ft., with USFS 54-2 and 54-9 signs attached, and another South, 3 ft., with USFS 54-2 sign attached. See associated Map of Survey dated September 19, 2024 for survey-related information.

RESTORATION BY, STAMP AND DATE:

Work performed July 31, 2024
Survey completed September 19, 2024

Jason L. Hatfield, PLS
Spencer B. Jones, Survey Tech

USDA FOREST SERVICE
NORTHEAST OREGON LAND ZONE
1550 Dewey Avenue, Suite A
Baker City, OR 97814
(541) 523-1283

FILED October 24, 2024
BAKER COUNTY SURVEYOR
SURVEY NO. 8-37-194

