


RECORD OF LAND CORNER MONUMENTATION

INTERSECTION OF SOUTHEASTERLY LINE OF VICTOR PLACER CLAIM, MINERAL SURVEY 194,
WITH THE NORTH-SOUTH CENTERLINE OF THE NW1/4 SECTION 33, T.8S., R.37E., W.M.

ORIGINALLY ESTABLISHED BY: CORNER NOT PREVIOUSLY ESTABLISHED

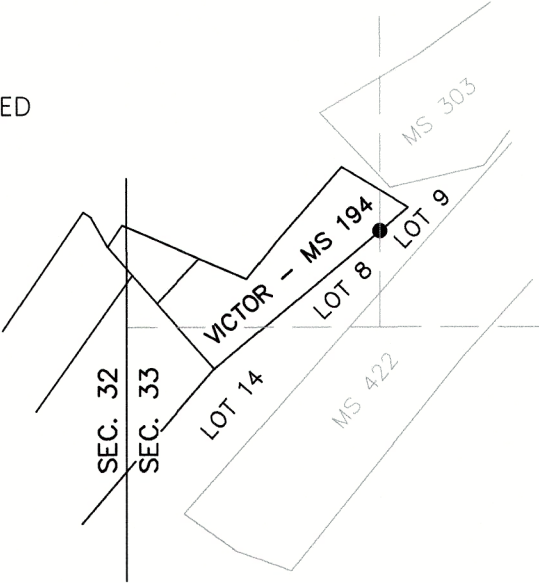

ORIGINAL DESCRIPTION: N/A

EVIDENCE FOUND: N/A

DESCRIPTION OF MONUMENTS AND ACCESSORIES SET AND METHODS USED:

At the intersection point, as determined by survey, I set a standard USFS 2 1/2" x 30" aluminum pipe with attached 3 1/4" aluminum cap, 24" in the ground. Built a 3 ft. diameter mound of stone to top. Cap is marked as shown below.


From which, I SCRIBE A NEW BEARING TREE:

- A western larch, 13" dbh, bears N.43°E., 18.42 ft. marked X in upper blaze, and BT in lower blaze.

I also SET A NEW REFERENCE POINT:

- A 5/8"x 30" iron pin, bears S.13°12'E., 32.24 ft., with attached 2" aluminum cap marked RP 1 2024 PLS 69454

CORNER MONUMENT
MARKED:

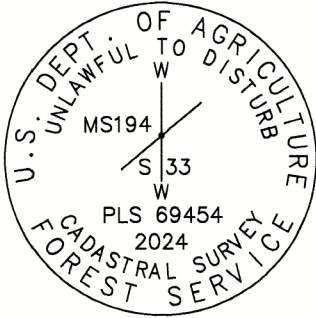

Placed a blue plastic-encased magnet at the base of the aluminum pipe. Painted a 6 inch red band around the bearing tree, and also painted the blazes red, and attached USFS 54-3 and 54-9 signs. Distance to bearing tree measured with a steel tape to a Mag Spike driven in the side-center-right at the root crown of the tree, with an attached 1 1/2" aluminum washer stamped PLS 69454. Used RTK GPS to measure the reference point. Bearings are geodetic, based on GPS observation taken at the corner. Set an aluminum guard post South, 7.3 ft., with USFS 54-2 sign attached, and another S.50°W., 4.3 ft., with USFS 54-2 and 54-9 signs attached. See associated Map of Survey dated September 19, 2024 for survey-related information.

RESTORATION BY, STAMP AND DATE:

Work performed July 31, 2024
Survey completed September 19, 2024

Jason L. Hatfield, PLS
Spencer B. Jones, Survey Tech

USDA FOREST SERVICE
NORTHEAST OREGON LAND ZONE
1550 Dewey Avenue, Suite A
Baker City, OR 97814
(541) 523-1283

FILED October 24, 2024
BAKER COUNTY SURVEYOR
SURVEY NO. 8-37-195

