

RECORD OF LAND CORNER MONUMENTATION

CORNER #1 SOUTH POLE QUARTZ CLAIM, MINERAL SURVEY 422,  
SITUATED IN SECTION 33, T. 8 S., R. 37 E., W.M.  
PAGE 1 OF 2


ORIGINALLY ESTABLISHED BY: John Hagel, U.S. Deputy Mineral Surveyor

MINERAL SURVEY NUMBER: 422

COMPLETION DATE: July 3, 1901

SUBSEQUENT SURVEYS:

- G.L.O. Retracement by Lincoln E. Wilkes, U.S. Cadastral Engineer, under Group No. 107, Approved May 26, 1927
- Unrecorded remonumentation by John R. Mitchell, an unlicensed Survey Technician, as documented on U.S. Forest Service corner card dated 9/22/1980
- Remonumented in 1985 by William R. Wells, PLS #1106. Corner Monumentation Record filed October 8, 1985 as Survey No. 8-37-27.

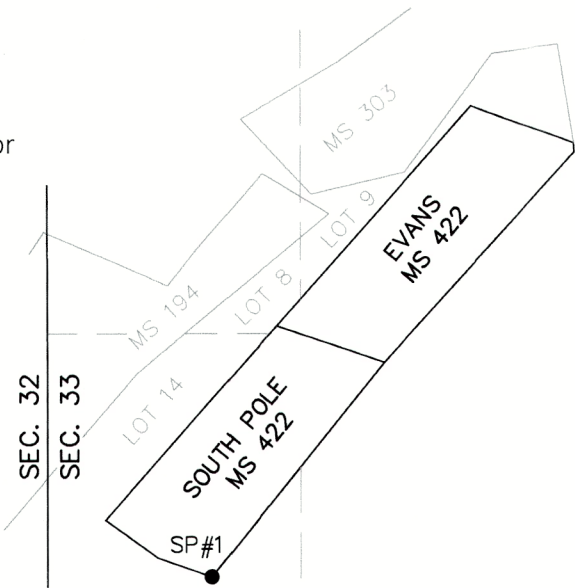

**ORIGINAL DESCRIPTION:** Beginning at Corner No. 1.  
Set a black pine post 4 ins. square, 4 1/2 ft. long, 18 ins. in the ground, with a mound of earth around it, scribed S. Pole Q.Cl., C.1-422.  
The south east loc. cor. bears S.29°10'W., 72.0 ft.  
A pine tree 6 ins. diam., bears N.32°30'W., 27.2 ft.;  
A pine tree 6 ins. diam., bears N.4°45'E., 26.2 ft.;  
both blazed and scribed S.Pole Q.Cl., C.1-422 B.T.

**G.L.O. DESCRIPTION:** Cor. No. 1, as described

**MITCHELL'S 1980 DESCRIPTION:**  
*DESCRIBE CORNER MONUMENT FOUND:* Rotted post in md of stone w/ Fragmentary scribing

*DESCRIBE BEARING TREES OR OTHER OFFICIAL ACCESSORIES FOUND:*  
Location Cor (a squared 10" Lpp) brs. S29°E 72'

*MONUMENT: DESCRIBE NEW MONUMENT SET, OR WORK DONE TO PRESERVE EXISTING MONUMENT:*  
Set 2 1/2" B.C. on 32" x 1" gal. pipe 20" deep in original hole in md of stone marked SPC1 MS422 1980

*ACCESSORIES: DESCRIBE NEW BT'S WITNESS OBJECTS ETC. ESTABLISHED, OR WORK DONE TO PRESERVE EXISTING EVIDENCE:*  
14" W.L. brs S24°E, 3 1/4' marked SP1 MS 422 B.T.  
10" W.L. brs N68°E 49' marked SP1 MS 422 B.T.

**WELLS' 1985 DESCRIPTION:**  
Mitchell's 2 1/2" brass cap on a 1 1/4" flanged g.i.p., protruding 4" from a stone mound. From Mitchell's monument:  
An uprooted, squared off lodgepole pine stump (location corner) bears S29 1/4°W-72'  
A 9" western larch bears N69°E-48.7' with visible scribing SP 1 MS 422 BT on partly healed blaze (by Mitchell).  
A 14" western larch bears S24°W-3.5' with visible scribing SP 1 MS 422 BT on partly healed blaze (by Mitchell).


Mitchell found a rotted post in a mound of stone with fragmentary scribing.

At the position occupied by Mitchell's monument, set a 2 1/2" by 30" aluminum pipe with 2 1/2" aluminum cap 24" in the ground and surrounded with a mound of stone. Buried Mitchell's monument horizontally next to the new monument.

FILED October 24, 2024  
BAKER COUNTY SURVEYOR  
SURVEY NO. 8-37-196

RECORD OF LAND CORNER MONUMENTATION


CORNER #1 SOUTH POLE QUARTZ CLAIM, MINERAL SURVEY 422,  
SITUATED IN SECTION 33, T. 8 S., R. 37 E., W.M.  
PAGE 2 OF 2

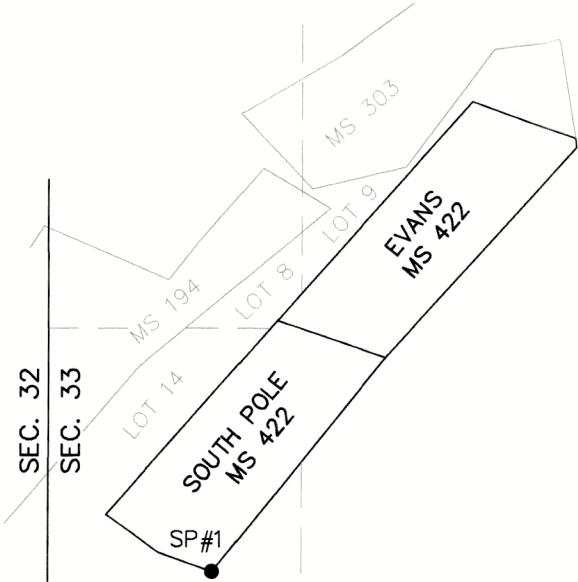

**EVIDENCE FOUND:** Found the monument set in 1985 by Wells in Survey No. 8-37-27, which is a 2 ½" aluminum pipe with 2 ½" aluminum cap, marked as shown below, projecting 4" above ground in a 1 ½ ft. diameter mound of stone. From which, a steel T post bears N.39°E., 3 ft., with a USFS 54-9 sign attached. From the found aluminum monument, I found the following bearing trees:

- ▶ A western larch, 12" dbh, bears N.69°E., 48.7 ft., with single healed blaze (Mitchell BT).
- ▶ A western larch, 15" dbh, bears S.24°W., 3.5 ft., with single healed blaze (Mitchell BT).

**DESCRIPTION OF MONUMENTS AND ACCESSORIES SET AND METHODS USED:**  
I accept the found monument for the true corner position. Cap is marked as shown below.

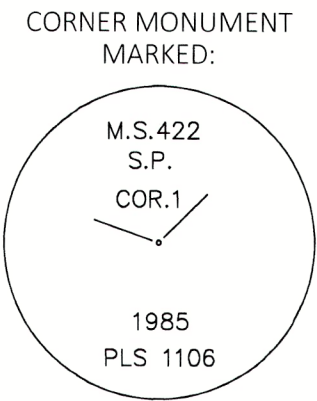

Painted a 6 inch red band around each bearing tree, and also painted the blazes red, and attached new USFS 54-3 and 54-9 signs. Distances to bearing trees measured with a handheld EDM. Bearings measured with a magnetic compass with 14° East declination. Set an aluminum guard post N.70°W., 4 ft., with USFS 54-2 sign attached. I also added a USFS 54-2 sign to the existing steel T post. See associated Map of Survey dated September 19, 2024 for survey-related information.

RESTORATION BY, STAMP AND DATE:

Work performed August 1, 2024  
Survey completed September 19, 2024  
  
Jason L. Hatfield, PLS

USDA FOREST SERVICE  
NORTHEAST OREGON LAND ZONE  
1550 Dewey Avenue, Suite A  
Baker City, OR 97814  
(541) 523-1283

FILED October 24, 2024  
BAKER COUNTY SURVEYOR  
SURVEY NO. 8-37-196

REGISTERED  
PROFESSIONAL  
LAND SURVEYOR

  
OREGON  
NOVEMBER 30, 2007  
JASON L. HATFIELD  
#69454  
EXPIRES: 6/30/2025