

RECORD OF LAND CORNER MONUMENTATION

CORNER #2 EXCELSIOR QUARTZ MINE, MINERAL SURVEY 165,
IDENTICAL WITH CORNER #1 NORTH POLE MINING CLAIM, MINERAL SURVEY 181,
ALSO IDENTICAL WITH CORNER #1 NORTH STAR QUARTZ CLAIM, MINERAL SURVEY 241,
ALSO IDENTICAL WITH CORNER #2 EXCELSIOR NO. 2 QUARTZ CLAIM, MINERAL SURVEY 244,
SITUATED IN SECTION 29, T. 8 S., R. 37 E., W.M.
PAGE 1 OF 2


ORIGINALLY ESTABLISHED BY: Henry W. Cooke, U.S. Deputy Mineral Surveyor

MINERAL SURVEY NUMBER: 165

COMPLETION DATE: November 8, 1887

SUBSEQUENT SURVEYS:

- ▶ Mineral Survey 181 by Emil F. Voigt, U.S. Deputy Mineral Surveyor, completed October 10, 1888
- ▶ Mineral Survey 241 by Emil F. Voigt, U.S. Deputy Mineral Surveyor, completed November 2, 1891
- ▶ Mineral Survey 244 by Emil F. Voigt, U.S. Deputy Mineral Surveyor, completed December 9, 1891
- ▶ G.L.O. Retracement by Lincoln E. Wilkes, U.S. Cadastral Engineer, under Group No. 107, Approved May 26, 1927
- ▶ Unrecorded remonumentation by John R. Mitchell, an unlicensed Survey Technician, as documented on U.S. Forest Service corner card dated 10/29/1980

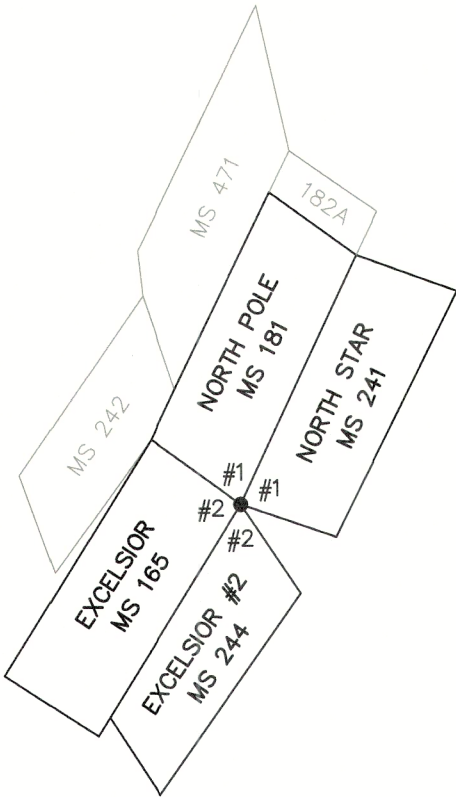

ORIGINAL DESCRIPTION: Set a post 4 ½ ft long 4 ins square in stone mound marked Cor No 2 E.M.C. Sur No 16 on West face of post from which
A fir 12 ins dia bears S10°W 6 feet dist marked Cor No 2 E.M.C. Sur No 16 BT
A fir 16 ins dia bears N42°W 14 feet dist marked Cor No 2 E.M.C. Sur No 16 BT

MINERAL SURVEY 181 DESCRIPTION: Beginning at corner No. 1, identical with corner No. 1 of the location and identical with Corner No. 2 of the Excelsior Quartz Claim (Survey No. 16) which is a black pine post 5 feet long 4 ½" square set 12" in the ground marked Corner No. 1. NPMC S No 181 with a mound of stone around it from which Mineral monument No. 1 bears S.44°30'W 2958 feet dist.
Tunnel No. 1 bears N.49°05'W. 423 feet dist
A black pine 11" dia blazed and marked N.P.M.C. S. No. 181 B.T. bears N.4°35'W 27.4 ft dist.
A fir 13" dia blazed and marked N.P.M.C. S. No. 181 BT. bears N.63°40'E. 16 ft dist.

MINERAL SURVEY 241 DESCRIPTION: To corner No. 1, identical with old location S.W. Cor. and with Cor. No. 2 Excelsior Cl. MS No. 16, and Cor. 1 North Pole Claim M.S. 178, which is a post 4 ½ feet long 4 inches square set 12 inches in the ground, with mound of stone, mark it on east face Cor. 1 N.S.Q.C. M.S. 241, from which Mineral Monument bears S.44°30'W. 2958 ft dist.
A Tamarack 10 inches Dia, bears N.82°30'E. 30 ft distant, marked Cor. 1 N.S.Q.C. M.S. 241 (B.T.)
A Tamarack 11 inches dia, bears S.78°E. 38 ft distant blazed and marked Cor. No. 1 N.S.Q.C. M.S. 241 (B.T.)

MINERAL SURVEY 244 DESCRIPTION: To Cor. No. 2, identical with old location N.W. Corner, and Cor. 1, North Star Claim Sur. 241, and Cor. 2 Excelsior Claim, and Cor. 1 North Pole Claim, which is a post 4 ½ ft long 4 inches square, set 12 inches in the ground ,with mound of stone, mark it on east face Cor. 2 E.No.2QC MS 244

G.L.O. DESCRIPTION: an iron pipe 2 ins. dia., 12 ins. above ground, firmly set, marked E 2 on iron cap, witnessed as described.

FILED September 24, 2025
BAKER COUNTY SURVEYOR
SURVEY NO. 8-37-204

RECORD OF LAND CORNER MONUMENTATION

CORNER #2 EXCELSIOR QUARTZ MINE, MINERAL SURVEY 165,
IDENTICAL WITH CORNER #1 NORTH POLE MINING CLAIM, MINERAL SURVEY 181,
ALSO IDENTICAL WITH CORNER #1 NORTH STAR QUARTZ CLAIM, MINERAL SURVEY 241,
ALSO IDENTICAL WITH CORNER #2 EXCELSIOR NO. 2 QUARTZ CLAIM, MINERAL SURVEY 244,
SITUATED IN SECTION 29, T. 8 S., R. 37 E., W.M.
PAGE 2 OF 2

MITCHELL'S 1980 DESCRIPTION:


DESCRIBE CORNER MONUMENT FOUND
2" iron pipe w/ iron cap marked E2 2 in md of stone

DESCRIBE BEARING TREES OR OTHER OFFICIAL ACCESSORIES FOUND
Roots of 12" WL brs. N82°30'E 30'
Roots of 14" WL brs. S78°E 38.30'
30" WF stump brs N58°E 18' w/ scribing
32" gr WF brs N37°W 14' w/HB

DESCRIBE CORNER LOCATION RELATIVE TO NEAR-BY FEATURES, ALSO HOW TO REACH CORNER
visible from road to Pole 4

MONUMENT: DESCRIBE NEW MONUMENT SET, OR WORK DONE TO PRESERVE EXISTING MONUMENT
Set 2 1/2" BC on 32" x 1" gal pipe 24" in the ground at cor pt in md of stone marked NS1 MS 241 1980

ACCESSORIES: DESCRIBE NEW BT'S WITNESS OBJECTS ETC. ESTABLISHED, OR WORK DONE TO PRESERVE EXISTING EVIDENCE:
16" WF brs N16°W 16' marked NS1 MS 241 BT

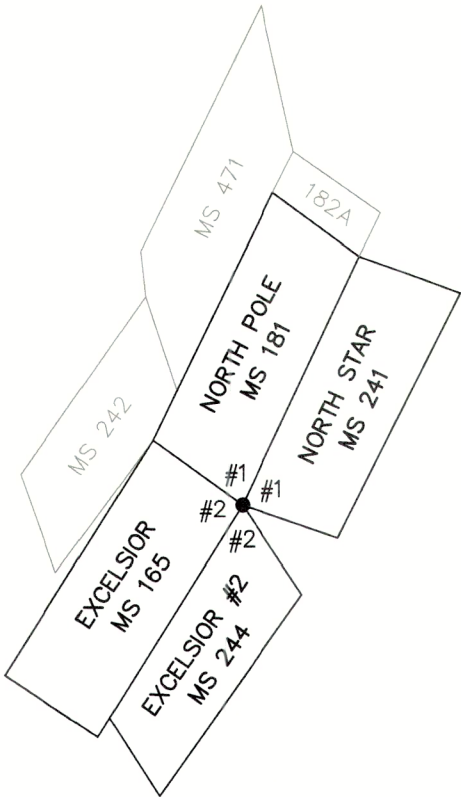


EVIDENCE FOUND: Found Mitchell's unrecorded monument, which is a 1 1/2" galvanized iron pipe with a 2 1/2" brass cap, marked as shown, projecting 4" above the top of a 2 ft. diameter mound of stone. From which,

- ▶ Rotten remains of a stump, size and species indeterminate, bears N.58°E, 18 ft. (MS 181 BT)
- ▶ A white fir, 33" dbh, bears N.38°30'W., 14.26 ft., with healed single blaze (Original BT)
- ▶ A Douglas-fir, 23" dbh, bears N.16°30'W., 21.92 ft., with fully-healed single blaze (Mitchell BT)

DESCRIPTION OF MONUMENTS AND ACCESSORIES SET AND METHODS USED: I accept Mitchell's brass cap monument as a faithful and accurate perpetuation of the original corner, being harmoniously related to the found accessory evidence, and to other found accepted corners in the area.

CORNER MONUMENT MARKED:

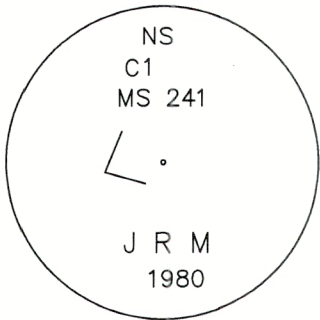

Painted a 6 inch red band around each bearing tree, and also painted healed blazes red, and attached new USFS 54-3 and 54-9 signs. Distances measured with a steel tape to a Mag Spike driven in the side-center-right at the root crown of each tree, with an attached 1 1/2" aluminum washer stamped PLS 69454. Used RTK GPS to measure bearings. Bearings are geodetic, based on GPS observation taken at the corner. See associated Map of Survey dated August 20, 2025 for survey-related information.

RESTORATION BY, STAMP AND DATE:

Work performed October 23, 2024
Survey completed August 20, 2025

Jason L. Hatfield, PLS
Spencer B. Jones, Survey Technician

USDA FOREST SERVICE
NORTHEAST OREGON LAND ZONE
1550 Dewey Avenue, Suite A
Baker City, OR 97814
(541) 523-1283

FILED September 24, 2025
BAKER COUNTY SURVEYOR
SURVEY NO. B-37-204

REGISTERED
PROFESSIONAL
LAND SURVEYOR


OREGON
NOVEMBER 30, 2007
JASON L. HATFIELD
#69454
EXPIRES: 6/30/2027