

RECORD OF LAND CORNER MONUMENTATION

CORNER #3 NORTH POLE MINING CLAIM, MINERAL SURVEY 181,
IDENTICAL WITH CORNER #4 WILLIAMS QUARTZ CLAIM, MINERAL SURVEY 182A,
SITUATED IN SECTION 28, T. 8 S., R. 37 E., W.M.
PAGE 1 OF 2


ORIGINALLY ESTABLISHED BY: Emil F. Voigt, U.S. Deputy Mineral Surveyor

MINERAL SURVEY NUMBER: 181

COMPLETION DATE: October 10, 1888

SUBSEQUENT SURVEYS:

- ▶ Mineral Survey 182 by Emil F. Voigt, U.S. Deputy Mineral Surveyor, completed October 11, 1888
- ▶ Mineral Survey 471 by John Hagel, U.S. Deputy Mineral Surveyor, completed June 4, 1902
- ▶ Unrecorded remonumentation by John R. Mitchell, an unlicensed Survey Technician, as documented on U.S. Forest Service corner card dated 5/10/1981

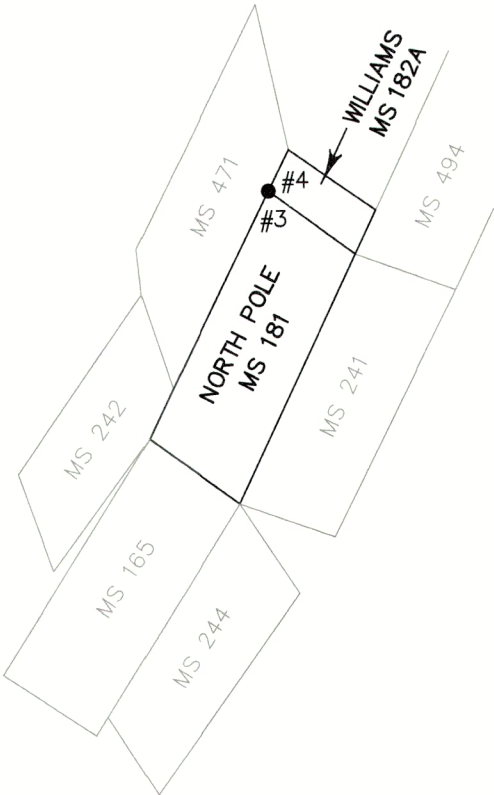

ORIGINAL DESCRIPTION: To corner No. 3. Set a black pine post 5 ft long 4 ½" square 12" in the ground marked corner No. 3 NPMC S No. 181, with a mound of stone around it from which Tunnel No. 2 bears S.2°30'E. 525.5 ft dist. A Fir 10" Dia bears N.21°05'E. 30.5 ft dist. marked Cor. No. 3 NPMC S No. 181 B.T. A Fir 18" dia bears N.39°30'W. 30 ft dist. marked Cor. No. 3 NPMC S No. 181 B.T.

MINERAL SURVEY 182A DESCRIPTION: to Corner No. 4. Identical with corner No. 4 of location and identical with corner No. 3 of North Pole mining claim Survey No. 181 which is a black pine post 5 ft long 4 ½" square set 12" in the ground marked Cor No. 4. WMC S No. 182 with a mound stone around it.

MINERAL SURVEY 471 DESCRIPTION: to corner no. 4 of the "Williams" Lode, identical with cor. no. 3 of the "North Pole" Lode M. Sur. No. 181

MITCHELL'S 1981 DESCRIPTION:
DESCRIBE CORNER MONUMENT FOUND
None

DESCRIBE BEARING TREES OR OTHER OFFICIAL ACCESSORIES FOUND
38" WF stump brs. N39°30'W 30'
27" gr WF stump brs. N21°E 30 ½' both w/ HB


MONUMENT: DESCRIBE NEW MONUMENT SET, OR WORK DONE TO PRESERVE EXISTING MONUMENT
2 ½" BC on 1" X 32" gal. pipe set 21" deep in md of stone & earth & marked NPC 3 MS 181 JRM 1981 & angle

ACCESSORIES: DESCRIBE NEW BT'S WITNESS OBJECTS ETC. ESTABLISHED, OR WORK DONE TO PRESERVE EXISTING EVIDENCE:
11" WF brs N30°W 15' marked NP3 MS 181 BT

FILED September 24, 2025
BAKER COUNTY SURVEYOR
SURVEY NO. 8-37-206

RECORD OF LAND CORNER MONUMENTATION

CORNER #3 NORTH POLE MINING CLAIM, MINERAL SURVEY 181,
IDENTICAL WITH CORNER #4 WILLIAMS QUARTZ CLAIM, MINERAL SURVEY 182A,
SITUATED IN SECTION 28, T. 8 S., R. 37 E., W.M.
PAGE 2 OF 2

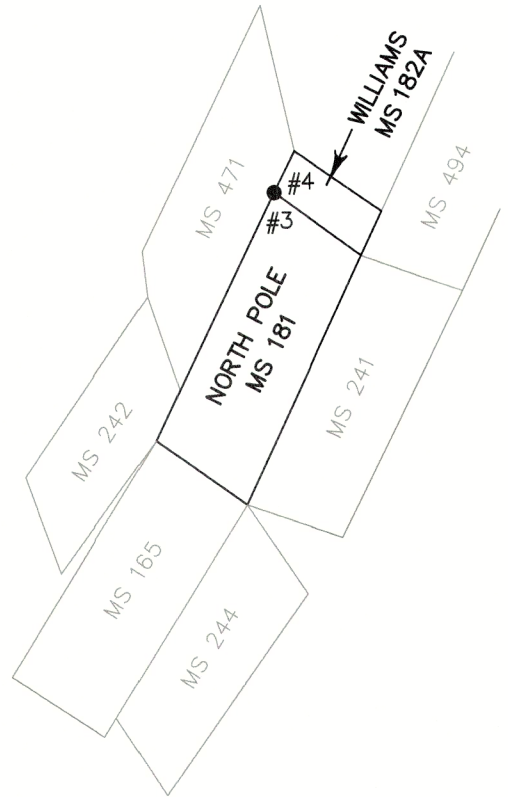

EVIDENCE FOUND: Found Mitchell's unrecorded monument, which is a 1 ½" galvanized iron pipe with a 2 ½" brass cap, marked as shown, projecting 9" above ground and leaning. I adjusted the monument to plumb, and built a 2 ft. diameter mound of stone around it to top. From which,

- ▶ A white fir snag, 28" dbh, bears N.20°09'E, 29.8 ft. with healed single blaze. I cut away approximately 7 inches of overgrowth to reveal old blaze with fragmentary scribing. Distance measured to face of blaze. (Original BT)
- ▶ A rotted white fir stump, 3 ft.+/- diameter, bears N.38°09'W., 30.7 ft., with partial blaze and fragmentary scribing. Distance measured to face of blaze. (Original BT)
- ▶ A Douglas-fir, 20" dbh, bears N.30°W., 14.92 ft. with fully-healed single blaze. (Mitchell BT)


DESCRIPTION OF MONUMENTS AND ACCESSORIES SET AND METHODS USED: I accept Mitchell's brass cap monument as a faithful and accurate perpetuation of the original corner, being harmoniously related to the found accessory evidence, and to other found accepted corners in the area.

From which, **I SCRIBE A NEW BEARING TREE:**

- ▶ A Douglas-fir, 14" dbh, bears S.01°11'E., 34.6 ft. marked *NP 3 - 181* in upper blaze, and *XBT* in lower blaze.

Painted a 6 inch red band around each bearing tree, and also painted blazes red, and attached new USFS 54-3 and 54-9 signs. Distances to Mitchell's bearing tree and the new bearing tree measured with a steel tape to a Mag Spike driven in the side-center-right at the root crown of each tree, with an attached 1 ½" aluminum washer stamped *PLS 69454*. Used RTK GPS to measure bearings. Bearings are geodetic, based on GPS observation taken at the corner. See associated Map of Survey dated August 20, 2025 for survey-related information.

CORNER MONUMENT MARKED:

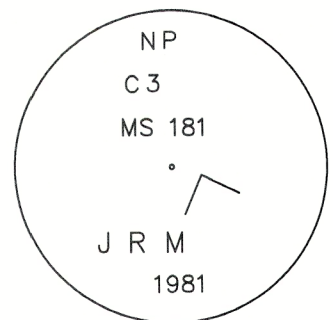

RESTORATION BY, STAMP AND DATE:

Work performed October 22, 2024
Survey completed August 20, 2025

Jason L. Hatfield, PLS
Spencer B. Jones, Survey Technician

USDA FOREST SERVICE
NORTHEAST OREGON LAND ZONE
1550 Dewey Avenue, Suite A
Baker City, OR 97814
(541) 523-1283

FILED September 24, 2025
BAKER COUNTY SURVEYOR
SURVEY NO. 8-37-206

REGISTERED
PROFESSIONAL
LAND SURVEYOR

Jason L. Hatfield
OREGON
NOVEMBER 30, 2007
JASON L. HATFIELD
#69454
EXPIRES: 6/30/2027