

RECORD OF LAND CORNER MONUMENTATION

CORNER #1 WILLAMETTE PLACER CLAIM, MINERAL SURVEY 191,
SITUATED IN SECTION 32, T. 8 S., R. 37 E., W.M.
PAGE 1 OF 2


ORIGINALLY ESTABLISHED BY: Emil F. Voigt, U.S. Deputy Mineral Surveyor

MINERAL SURVEY NUMBER: 191

COMPLETION DATE: December 18, 1888

SUBSEQUENT SURVEYS:

- Retracement by Arthur Philbrick and Porter McGee completed October 19, 1895
- G.L.O. Retracement by Lincoln E. Wilkes, U.S. Cadastral Engineer, under Group No. 107, Approved May 26, 1927
- Corner search notes by John R. Mitchell, an unlicensed Survey Technician, as documented on U.S. Forest Service corner card dated 7/30/1969
- Unrecorded remonumentation by John R. Mitchell, an unlicensed Survey Technician, as documented on U.S. Forest Service corner card (undated)

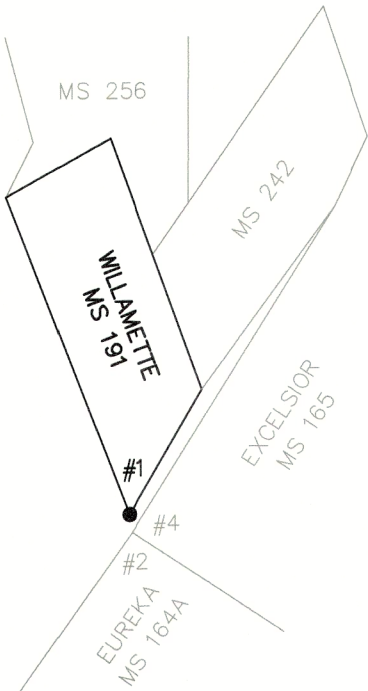

ORIGINAL DESCRIPTION: Commencing at corner No. 1 which is a fir post 5 ft long 4½" square 12" in the ground with mound of stone around it marked cor. No. 1 WPMC SN 191, identical with location corner No. 1 from which Mineral Monument No. 1 bears S31°45'W, 1444 feet dist
Corner No. 2 Eureka Mine bears S39°15'E 2.8 feet dist
A Fir 20" Dia blazed and marked cor No. 1 WPMC SN 191 BT bears N.28°W. 51 links dist
A Fir 22" Dia blazed and marked cor No. 1 WPMC SN 191 BT bears S.88°45'W. 61 lks dist

PHILBRICK AND MCGEE'S 1895 DESCRIPTION: Plat contains note at corner which reads "Original Corner with bearing trees Cor No. 1" and "Cor. No. 1 Eureka Mine bears S.39°15'E. 2.8 ft. dist.

G.L.O. DESCRIPTION: Beginning at cor. No. 1, Willamette Placer Claim, an iron pipe, 2 ins. dia., 12 ins. above ground, firmly set, with iron cap marked W 1, witnessed as described.

MITCHELL'S 1969 DESCRIPTION:

DESCRIBE CORNER MONUMENT FOUND

Pipe w/cap, 2" diam. - 14" above ground good condition marked W-1

DESCRIBE BEARING TREES OR OTHER OFFICIAL ACCESSORIES FOUND

CORS. 2 AND 3 of E. AND E. MINE bears N.33 ½°W. 2.8' dist.

MITCHELL'S 1980 DESCRIPTION:

MONUMENT: DESCRIBE NEW MONUMENT SET, OR WORK DONE TO PRESERVE EXISTING MONUMENT

Set 2 ½" B.C. on 1"X 32" gal. pipe 24" deep in original md of stone marked WPC1 MS 191 1980

ACCESSORIES: DESCRIBE NEW BT'S WITNESS OBJECTS ETC. ESTABLISHED, OR WORK DONE TO PRESERVE EXISTING EVIDENCE:


10" WF brs N35°W 11 Lks marked WP1 MS 191 BT

8" DF brs N23°W 19 Lks marked WP1 MS 191 BT

FILED September 24, 2025
BAKER COUNTY SURVEYOR
SURVEY NO. 8-37-208

RECORD OF LAND CORNER MONUMENTATION

CORNER #1 WILLAMETTE PLACER CLAIM, MINERAL SURVEY 191,
SITUATED IN SECTION 32, T. 8 S., R. 37 E., W.M.
PAGE 2 OF 2

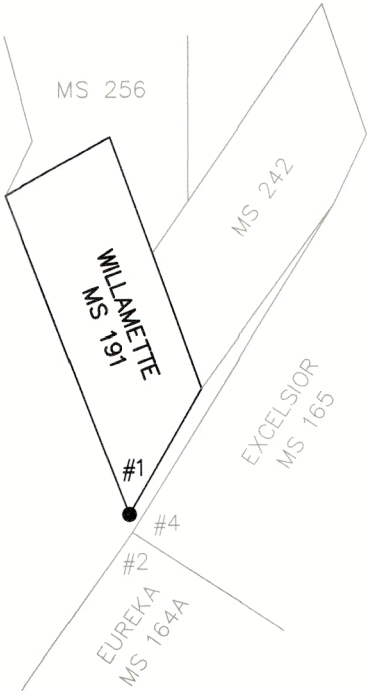

EVIDENCE FOUND: Found Mitchell's unrecorded monument, which is a 1 1/2" galvanized iron pipe with a 2 1/2" brass cap, marked as shown, projecting 4" above ground in a 3 ft. diameter mound of stone. From which,

- Corner No. 2 Eureka Quartz Mine, MS 164A, identical with Corner No. 4 Excelsior Quartz Mine, MS 165, monumented with an unrecorded 1 1/2" galvanized iron pipe with a 2 1/2" brass cap, established by John R. Mitchell, bears S.34°E., 2.86 ft.

Both of Mitchell's bearing trees are dead and down, and very rotten.

DESCRIPTION OF MONUMENTS AND ACCESSORIES SET AND METHODS USED: I accept Mitchell's brass cap monument as a faithful and accurate perpetuation of the original corner, being harmoniously related to the found accessory evidence, and to other found accepted corners in the area.


From which, **A BEARING TREE BY MITCHELL FOR COR. #2 EUREKA:**

- A western larch, 12" dbh, bears S.43°W., 5.79 ft. with fully-healed single blaze.

Also from which, **I SCRIBE A NEW BEARING TREE:**

- An Engelmann spruce, 10" dbh, bears N.38°W., 6.51 ft. marked WP 1 - 191 in upper blaze, and XBT in lower blaze.

CORNER MONUMENT
MARKED:

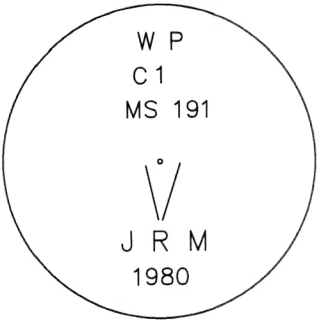

Painted a 6 inch red band around the bearing trees, and also painted the blazes red, and attached new USFS 54-3 and 54-9 signs. Distances measured with a steel tape to a Mag Spike driven in the side-center-right at the root crown of each tree, with an attached 1 1/2" aluminum washer stamped PLS 69454. Used a magnetic compass with 14° East declination to measure bearings to BT's. Set an aluminum guard post N.21°W., 5 ft. with USFS 54-2 and 54-9 signs attached. See associated Map of Survey dated August 20, 2025 for survey-related information.

RESTORATION BY, STAMP AND DATE:

Work performed September 10, 2024
Survey completed August 20, 2025

Jason L. Hatfield, PLS
Spencer B. Jones, Survey Technician

USDA FOREST SERVICE
NORTHEAST OREGON LAND ZONE
1550 Dewey Avenue, Suite A
Baker City, OR 97814
(541) 523-1283

FILED September 24, 2025
BAKER COUNTY SURVEYOR
SURVEY NO. 8-37-208

REGISTERED
PROFESSIONAL
LAND SURVEYOR



OREGON
NOVEMBER 30, 2007
JASON L. HATFIELD
#69454

EXPIRES: 6/30/2027