

RECORD OF LAND CORNER MONUMENTATION

CORNER #3 WILLAMETTE PLACER CLAIM, MINERAL SURVEY 191,
IDENTICAL WITH CORNER #7 CENTRAL PLACER CLAIM, MINERAL SURVEY 256,
SITUATED IN SECTION 29, T. 8 S., R. 37 E., W.M.
PAGE 1 OF 2


ORIGINALLY ESTABLISHED BY: Emil F. Voigt, U.S. Deputy Mineral Surveyor

MINERAL SURVEY NUMBER: 191

COMPLETION DATE: December 18, 1888

SUBSEQUENT SURVEYS:

- ▶ Mineral Survey 256 by Emil F. Voigt, U.S. Deputy Mineral Surveyor, completed September 10, 1892
- ▶ Retracement by Arthur Philbrick and Porter McGee completed October 29, 1895.
- ▶ Unrecorded remonumentation by John R. Mitchell, an unlicensed Survey Technician, as documented on U.S. Forest Service corner card dated 9/17/1980

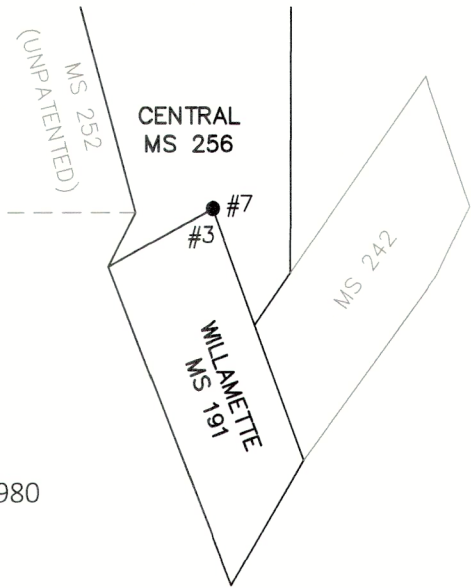

ORIGINAL DESCRIPTION: To corner No. 3 A Fir post 5 ft long 4 1/2" square set 12" in the ground with mound of stone around it, marked Cor. No. 3 WPMC SN 191 identical with old location corner No. 3 from which A Fir 22" Dia blazed and marked corner No. 3 WPMC SN 191 BT bears S.67.30° 45 lks dist. A Fir 14" Dia blazed and marked cor No. 3 WPMC SN 191 BT. bears S.27°15'W. 49 lks dist.

MINERAL SURVEY 256 DESCRIPTION: To corner No. 7, identical with old location Corner No. 7 and cor. 3 Willamette Claim, previously described mark it on east and north faces Cor No. 7 CPC MSN256 from which A Tamarack 12 inches dia bears S.73°W. 56L distant blazed and marked Cor No. 7 C.P.C. M.S. No. 256 (BT) A Tamarack 18 inches dia bears N.66°W. 87L distant blazed and marked Cor No. 7 C.P.C. M.S. No. 256 (BT)

PHILBRICK AND McGEE'S 1895 DESCRIPTION: Plat contains note at corner which reads "Original Corner"

MITCHELL'S 1980 DESCRIPTION:

DESCRIBE CORNER MONUMENT FOUND
Rotted post in md of stone

DESCRIBE BEARING TREES OR OTHER OFFICIAL ACCESSORIES FOUND
28" WL brs S71°W 54 lks w/ full scribing

DESCRIBE CORNER LOCATION RELATIVE TO NEAR-BY FEATURES, ALSO HOW TO REACH CORNER
The angle of this cor shown here is incorrect to agree with corners on the ground


MONUMENT: DESCRIBE NEW MONUMENT SET, OR WORK DONE TO PRESERVE EXISTING MONUMENT
Planted 2 1/2" B.C. on 1" x 32" gal pipe 24" deep in md of stone in original hole marked CPC C7 MS256 1980

ACCESSORIES: DESCRIBE NEW BT'S WITNESS OBJECTS ETC. ESTABLISHED, OR WORK DONE TO PRESERVE EXISTING EVIDENCE:
8" D.F. brs S60°W 24 lks marked CPC7 MS256 BT
8" A.F. brs N50°E 13 lks marked CPC7 MS256 BT

FILED September 24, 2025
BAKER COUNTY SURVEYOR
SURVEY NO. 8-37-209

RECORD OF LAND CORNER MONUMENTATION

CORNER #3 WILLAMETTE PLACER CLAIM, MINERAL SURVEY 191,
IDENTICAL WITH CORNER #7 CENTRAL PLACER CLAIM, MINERAL SURVEY 256,
SITUATED IN SECTION 29, T. 8 S., R. 37 E., W.M.
PAGE 2 OF 2

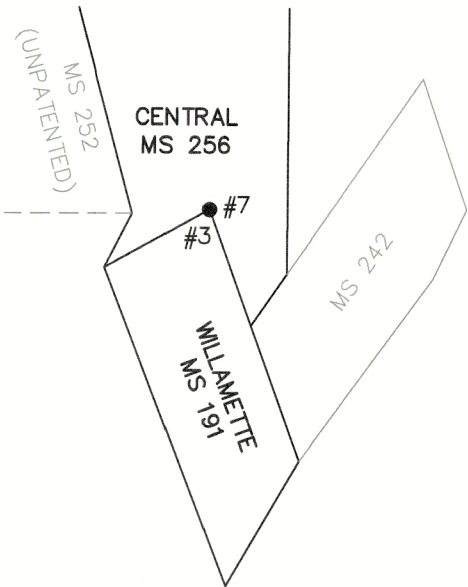

EVIDENCE FOUND: Found Mitchell's unrecorded monument, which is a 1 1/2" galvanized iron pipe with a 2 1/2" brass cap, marked as shown, in a 3 ft. diameter mound of stone. From which, I also found the following bearing trees:


- ▶ A dead and down (wind thrown) western larch, 28" diam, with opened blaze and visible scribing, bears S.69°W., 35 ft. to approximate center of root wad hole (MS 256 BT).
- ▶ Both of Mitchell's bearing trees are dead and down, and unrecognizable. I found one of the BT tags laying on the ground nearby. I searched for but found no remains of the stumps, which have apparently rotted away.

DESCRIPTION OF MONUMENTS AND ACCESSORIES SET AND METHODS USED: I accept Mitchell's brass cap monument as a faithful and accurate perpetuation of the original corner, being harmoniously related to the original accessory evidence. Cap is marked as shown.

From which, **I SET NEW REFERENCE POINTS:**

- ▶ A 5/8"x 24" iron pin, bears N.10°14'W., 9.93 ft., with attached 2" aluminum cap marked *RP 1 2025 PLS 69454*
- ▶ A 5/8"x 24" iron pin, bears S.85°53'E., 8.10 ft., with attached 2" aluminum cap marked *RP 2 2025 PLS 69454*

CORNER MONUMENT MARKED:

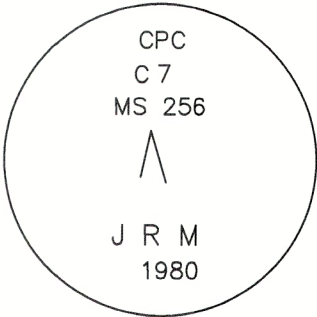

Used RTK GPS to measure the accessories. Bearings are geodetic, based on GPS observation taken at the corner. Set an aluminum guard post alongside, with a USFS 54-9 sign attached. See associated Map of Survey dated August 20, 2025 for survey-related information.

RESTORATION BY, STAMP AND DATE:

Work performed July 24, 2025
Survey completed August 20, 2025

Jason L. Hatfield, PLS
Vince L. Kelly, Survey Technician

USDA FOREST SERVICE
NORTHEAST OREGON LAND ZONE
1550 Dewey Avenue, Suite A
Baker City, OR 97814
(541) 523-1283

FILED September 24, 2025
BAKER COUNTY SURVEYOR
SURVEY NO. 8-37-209

REGISTERED
PROFESSIONAL
LAND SURVEYOR


OREGON
NOVEMBER 30, 2007
JASON L. HATFIELD
#69454
EXPIRES: 6/30/2027