

RECORD OF LAND CORNER MONUMENTATION

CORNER #2 SUMMIT QUARTZ CLAIM, MINERAL SURVEY 238,
IDENTICAL WITH CORNER #1 FRACTIONAL QUARTZ CLAIM, MINERAL SURVEY 238,
ALSO IDENTICAL WITH CORNER #2 CONSOLIDATED FRACTIONAL QUARTZ CLAIM, MINERAL SURVEY 238,
SITUATED IN SECTION 32, T. 8 S., R. 37 E., W.M.
PAGE 1 OF 2


ORIGINALLY ESTABLISHED BY: Charles M. Foster, U.S. Deputy Mineral Surveyor

MINERAL SURVEY NUMBER: 238

COMPLETION DATE: September 10, 1891

SUBSEQUENT SURVEYS:

- G.L.O. Retracement by Lincoln E. Wilkes, U.S. Cadastral Engineer, under Group No. 107, Approved May 26, 1927
- Unrecorded remonumentation by John R. Mitchell, an unlicensed Survey Technician, as documented on U.S. Forest Service corner card dated 6/15/1981

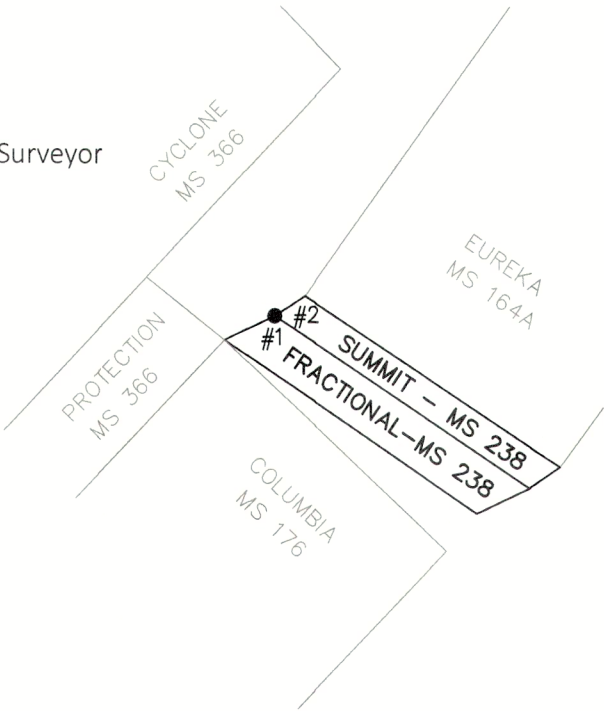

ORIGINAL DESCRIPTION "SUMMIT QUARTZ CLAIM": to corner No. 2 (no original corner here) Set Post 4 ½ ft. long 4 inches square 12 inches in the ground with mound of Earth and Rocks 5 feet square & 2 ½ ft. high marked Cor. No. 2. S.C. Sur. 238.
From which a Pine 3 ft. dia bears S.45°E. 24 ft. dist. marked S.C. Cor. No. 2 BT.

ORIGINAL DESCRIPTION "FRACTIONAL QUARTZ CLAIM": Commencing at a Post and mound previously described as corner No. 2 in the survey of the exterior boundaries of the Summit Claim this post I marked Cor. No. 1 F.C. Sur. 238 from which Mineral Monument No. 1 previously described bears N.79 ½°E 172 feet dist

ORIGINAL DESCRIPTION "CONSOLIDATED FRACTIONAL QUARTZ CLAIM": To corner No. 2 which is also corner No. 2 of the Summit Claim and corner No. 1 Fractional Claim. Marked Post Cor. 2. Con. F.C. from which a pine 3 ft. dia bears S.45°E. 24 ft. dist. marked Con. F.C. No. 2 BT.

G.L.O. DESCRIPTION: Cor. No. 1, common with cor. No. 2, Summit Claim, same survey, as described.

MITCHELL'S 1981 DESCRIPTION:
DESCRIBE CORNER MONUMENT FOUND
mound of stone

DESCRIBE BEARING TREES OR OTHER OFFICIAL ACCESSORIES FOUND
40" Dead pp fully scribed brs S45°E 24'


MONUMENT: DESCRIBE NEW MONUMENT SET, OR WORK DONE TO PRESERVE EXISTING MONUMENT
2 ½" BC on 1" X 32" gal pipe set 25" deep in original md marked SMT C2 MS 238 JRM 1981 & angle

ACCESSORIES: DESCRIBE NEW BT'S WITNESS OBJECTS ETC. ESTABLISHED, OR WORK DONE TO PRESERVE EXISTING EVIDENCE:
9" PP brs S5°E 4'
12" DF brs N8°E 10 ½' both marked SU2 MS 238 BT

FILED September 24, 2025
BAKER COUNTY SURVEYOR
SURVEY NO. 8-37-213

RECORD OF LAND CORNER MONUMENTATION

CORNER #2 SUMMIT QUARTZ CLAIM, MINERAL SURVEY 238,
IDENTICAL WITH CORNER #1 FRACTIONAL QUARTZ CLAIM, MINERAL SURVEY 238,
ALSO IDENTICAL WITH CORNER #2 CONSOLIDATED FRACTIONAL QUARTZ CLAIM, MINERAL SURVEY 238,
SITUATED IN SECTION 32, T. 8 S., R. 37 E., W.M.
PAGE 2 OF 2

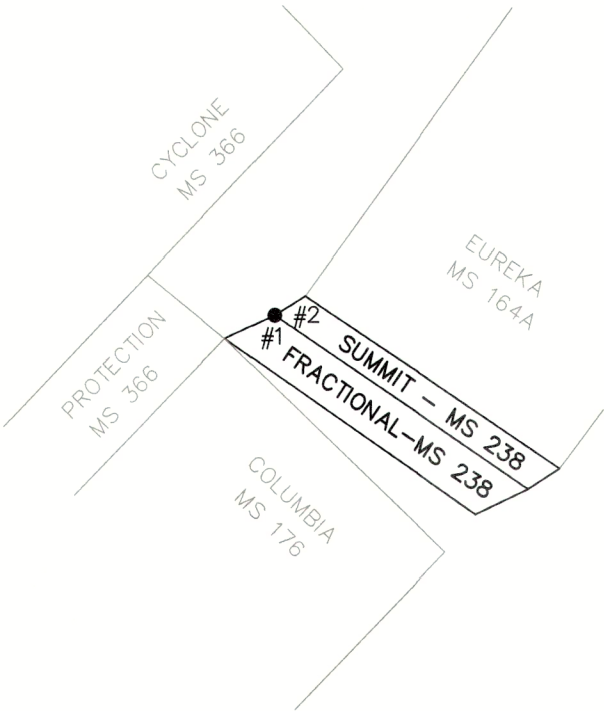

EVIDENCE FOUND: Found Mitchell's unrecorded monument, which is a 1 1/2" galvanized iron pipe with a 2 1/2" brass cap, marked as shown, projecting 3" above ground in a 4 ft. diameter mound of earth and stone. From which,

- A ponderosa pine, 10" dbh, bears S.08°E., 4.13 ft., with fully-healed single blaze (Mitchell BT). Tree is green, but top is broken out.
- A large root wad hole bears S.43°E., 24 feet (to center), with dead and down ponderosa pine, 40" diameter, with root wad attached, laying nearby, which has been pushed off the road with heavy equipment. The bole has a large open blaze with many fragmentary scribe marks, among which S and BT are legible (Original BT)
- A Douglas-fir, 17" dbh, bears N.09°W, 10.70 ft., with fully-healed single blaze (Mitchell BT)


DESCRIPTION OF MONUMENTS AND ACCESSORIES SET AND METHODS USED: I accept Mitchell's brass cap monument as a faithful and accurate perpetuation of the original corner, being harmoniously related to the found accessory evidence, and to other found accepted corners in the area.

From which, **I SCRIBE A NEW BEARING TREE:**

- A ponderosa pine 10" dbh, bears N.83°W., 10.41 ft. marked X in upper blaze, and BT in lower blaze.

Painted a 6 inch red band around each bearing tree, and also painted the blazes red, and attached new USFS 54-3 and 54-9 signs. Distances measured with a steel tape to a Mag Spike driven in the side-center-right at the root crown of each tree, with an attached 1 1/2" aluminum washer stamped PLS 69454. Used RTK GPS to measure bearings. Bearings are geodetic, based on GPS observation taken at the corner. Set an aluminum guard post S.65°W., 3 ft. with USFS 54-2 and 54-9 signs attached. See associated Map of Survey dated August 20, 2025 for survey-related information.

CORNER MONUMENT MARKED:

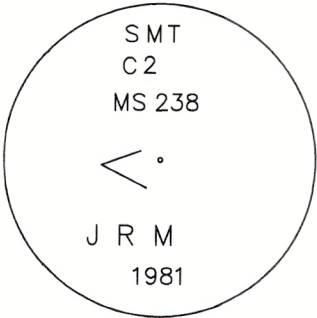



RESTORATION BY, STAMP AND DATE:

Work performed August 12, 2024
Survey completed August 20, 2025

Jason L. Hatfield, PLS

USDA FOREST SERVICE
NORTHEAST OREGON LAND ZONE
1550 Dewey Avenue, Suite A
Baker City, OR 97814
(541) 523-1283

FILED September 24, 2025
BAKER COUNTY SURVEYOR
SURVEY NO. 8-37-213

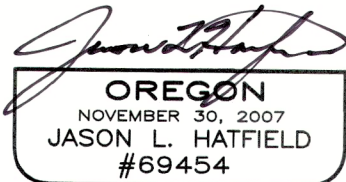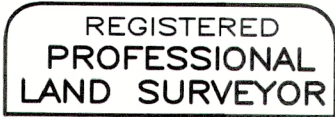

EXPIRES: 6/30/2027