

RECORD OF LAND CORNER MONUMENTATION

CORNER #3 RAGING ROLAND QUARTZ CLAIM, MINERAL SURVEY 242,
SITUATED IN SECTION 29, T. 8 S., R. 37 E., W.M.
PAGE 1 OF 2


ORIGINALLY ESTABLISHED BY: Emil F. Voigt, U.S. Deputy Mineral Surveyor

MINERAL SURVEY NUMBER: 242

COMPLETION DATE: November 3, 1891

SUBSEQUENT SURVEYS:

- ▶ Mineral Survey 471 by John Hagel, U.S. Deputy Mineral Surveyor, completed June 4, 1902
- ▶ Mineral Survey 676 by John Hagel, U.S. Deputy Mineral Surveyor, completed October 6, 1906 (unpatented)
- ▶ G.L.O. Retracement by Lincoln E. Wilkes, U.S. Cadastral Engineer, under Group No. 107, Approved May 26, 1927
- ▶ Unrecorded remonumentation by John R. Mitchell, an unlicensed Survey Technician, as documented on U.S. Forest Service corner card dated 6/11/1981

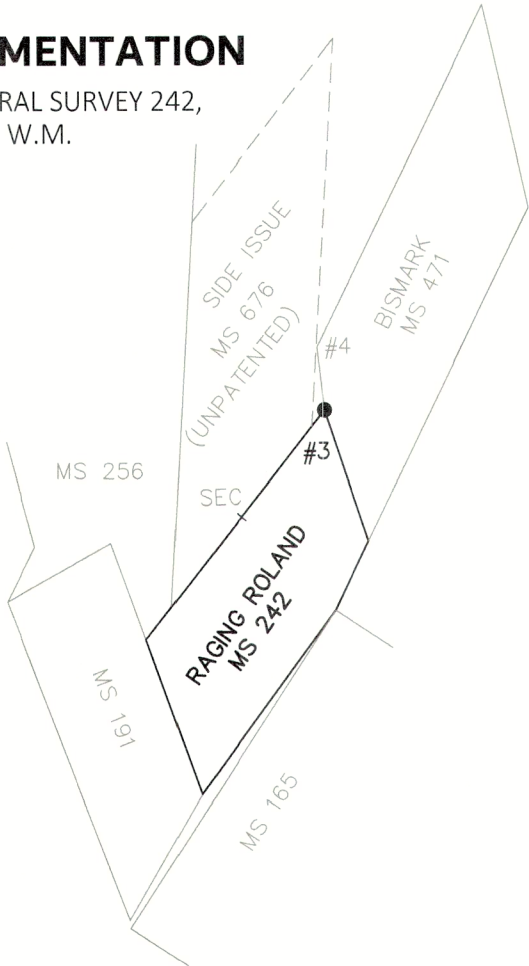

ORIGINAL DESCRIPTION: to Cor. No. 3, set a post 4 1/2 ft long 4 inches square 12 inches in the ground, with mound of stone, marked Cor. 3, R.R.Q.C. M.S. 242, from which old location N.W. Cor. bears N.34°30'E. 359 ft. distant
A Fir 65 inches dia bears S.13°30'E. 10 ft distant blazed and marked Cor 3 R.R.Q.C. M.S. 242 (B.T.)
A Fir 30 inches dia bears S.88°W. 32 ft distant blazed and marked Cor 3 R.R.Q.C. M.S. 242 (B.T.)

MINERAL SURVEY 471 DESCRIPTION: To cor. No. 3 of the "Raging Roland" Lode M. Sur. No. 242

MINERAL SURVEY 676 DESCRIPTION: To corner No. 2 on the second course of the Raging Roland Lode M.S. No. 242
Set a red fir post 5 ins. square 4.5 ft long 18 ins. in the ground, scribed S.I.Q.CL.C. 2 - 676 with a mound of earth around it.....The S.E. cor. of the location, identical with Cor. No. 3 of the Raging Roland Lode bears N.37°30'E. 80.8 ft.

G.L.O. DESCRIPTION: To cor. No. 3, as described.

MITCHELL'S 1981 DESCRIPTION:
DESCRIBE CORNER MONUMENT FOUND
Rotted post in md of stone

DESCRIBE BEARING TREES OR OTHER OFFICIAL ACCESSORIES FOUND
42" WF snag w/full scribing brs S.88°W 32'


MONUMENT: DESCRIBE NEW MONUMENT SET, OR WORK DONE TO PRESERVE EXISTING MONUMENT
2 1/2" BC on 1" X 32" gal. pipe set 24" deep in original hole & md marked RRC 3 MS 242 JRM 1981 & angle

ACCESSORIES: DESCRIBE NEW BT'S WITNESS OBJECTS ETC. ESTABLISHED, OR WORK DONE TO PRESERVE EXISTING EVIDENCE:
8" WF brs S77°W 16 1/2'
7" WF brs N66°W 17' both marked RR 3 MS 242 B.T.

FILED September 24, 2025
BAKER COUNTY SURVEYOR
SURVEY NO. 8-37-214

RECORD OF LAND CORNER MONUMENTATION

CORNER #3 RAGING ROLAND QUARTZ CLAIM, MINERAL SURVEY 242,
SITUATED IN SECTION 29, T. 8 S., R. 37 E., W.M.
PAGE 2 OF 2

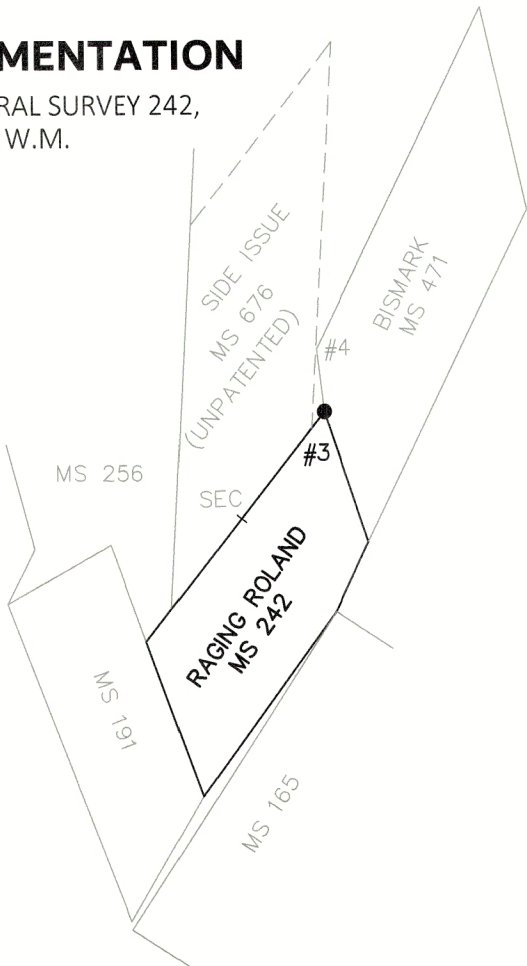

EVIDENCE FOUND: The corner falls on the cut bank of a skid trail. Mitchell's brass cap monument was found mangled and buried in the fill of the skid trail about 40 feet from the corner. I also found the original southwest bearing tree, which is a white fir snag, 41" in diameter, with scribing *C4 MS 242 BT* visible in an opened blaze. Although the corner number is incorrect, the style of the scribing matches other found bearing trees scribed by Voigt, and it is in the record location. I accept the bearing tree as sufficient accessory evidence of the original corner. I reestablish the corner at record bearing and distance from the found bearing tree, measuring from the face of the blaze. This places the corner in a position which is harmoniously related to the found accepted monument at Corner No. 4 of Bismark Quartz Claim, MS 471 (based on the G.L.O. record), and also the South-End-Center of Side Issue claim, MS 676 . Mitchell's bearing trees both fall within the fill slope of the skid trail, and neither one could be positively identified.


DESCRIPTION OF MONUMENTS AND ACCESSORIES SET AND METHODS USED: At the corner point, I set a standard USFS 2 ½" x 30" aluminum pipe with attached 3 ¼" aluminum cap, 28" in the ground. Raised a 2 ½ ft. diameter mound of stone around the monument to top of cap. Cap is marked as shown below.

From which, **I SCRIBE NEW BEARING TREES:**

- A Douglas-fir, 13" dbh, bears N.87°E., 7.03 ft. marked *RR3-242* in upper blaze, and *XBT* in lower blaze.
- A lodgepole pine, 13" dbh, bears N.39°E., 19.89 ft. marked *RR3-242* in upper blaze, and *XBT* in lower blaze.

Placed a light blue plastic-encased magnet at the base of the pipe. Painted a 6 inch red band around each bearing tree, and also painted the blazes red, and attached new USFS 54-3 and 54-9 signs. Distances measured with a steel tape to a Mag Spike driven in the side-center-right at the root crown of each tree, with an attached 1 ½" aluminum washer stamped *PLS 69454*. Used RTK GPS to measure bearings. Bearings are geodetic, based on GPS observation taken at the corner. Set an aluminum guard post N.07°W., 4 ft.+/- with USFS 54-2 and 54-9 signs attached. See associated Map of Survey dated August 20, 2025 for survey-related information.

CORNER MONUMENT MARKED:

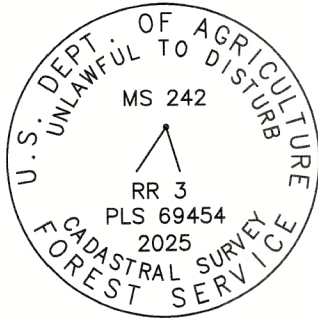

RESTORATION BY, STAMP AND DATE:

Work performed July 16, 2025
Survey completed August 20, 2025

Jason L. Hatfield, PLS

USDA FOREST SERVICE
NORTHEAST OREGON LAND ZONE
1550 Dewey Avenue, Suite A
Baker City, OR 97814
(541) 523-1283

FILED September 24, 2025
BAKER COUNTY SURVEYOR
SURVEY NO. 8-37-214

