

RECORD OF LAND CORNER MONUMENTATION

CORNER #1 CENTRAL PLACER CLAIM, MINERAL SURVEY 256,
IDENTICAL WITH CORNER #1 THOMPSON QUARTZ CLAIM, MINERAL SURVEY 252 (UNPATENTED),
SITUATED IN SECTION 29, T. 8 S., R. 37 E., W.M.
PAGE 1 OF 2


ORIGINALLY ESTABLISHED BY: Emil F. Voigt, U.S. Deputy Mineral Surveyor

MINERAL SURVEY NUMBER: 252

COMPLETION DATE: June 18, 1892

SUBSEQUENT SURVEYS:

- ▶ Mineral Survey 256 by Emil F. Voigt, U.S. Deputy Mineral Surveyor, completed September 10, 1892
- ▶ G.L.O. Retracement by Lincoln E. Wilkes, U.S. Cadastral Engineer, under Group No. 107, Approved May 26, 1927
- ▶ Corner search notes by John R. Mitchell, an unlicensed Survey Technician, as documented on U.S. Forest Service corner card dated 7/28/1969
- ▶ Unrecorded remonumentation by John R. Mitchell, an unlicensed Survey Technician, as documented on U.S. Forest Service corner (undated)

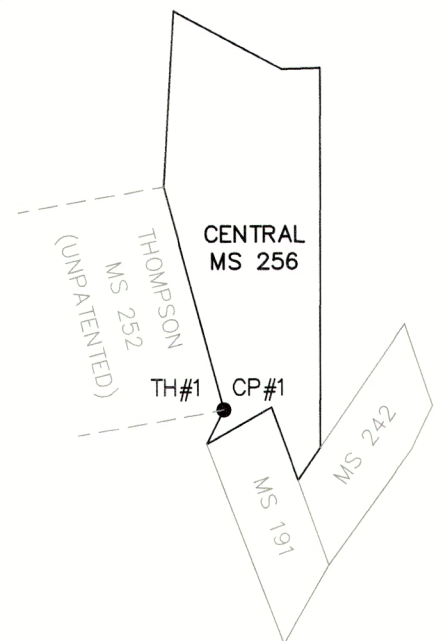

ORIGINAL DESCRIPTION: To corner No. 1, identical with old location S.E. Corner. Set a post $4\frac{1}{2}$ feet long 4 inches square, 12 inches in the ground, with mound of stone, marked Cor. 1 T.Q.C. from which
A tamarack 16 inches dia, blazed and marked Cor. 1 T.Q.C. (B.T.) bears N.87°W. 11 feet distant.
A Fir 12 inches dia, blazed and marked (B.T.) bears S.15°30'W. 36 feet distant.

MINERAL SURVEY 256 DESCRIPTION: Beginning at Corner No. 1, identical with Cor. 1 of location and Cor. 1 Tacoma Cons. Claim M.S. No. 252, previously described, mark it on East face Cor. No. 1 C.P.C. M.S. No. 256, from which Mineral Monument No. 1, in T.8S., Rge 37 E. W.M. bears S.17°30'W. 2425 feet distant.

G.L.O. DESCRIPTION: Cor. No. 1, common with cor. No. 1, Thompson Claim, Sur. No. 252, as described.

MITCHELL'S 1969 DESCRIPTION:

DESCRIBE CORNER MONUMENT FOUND

1" pipe in old mound of stone
14" above ground - Good Condition
Also rotted post of original survey

DESCRIBE BEARING TREES OR OTHER OFFICIAL ACCESSORIES FOUND

32" fir (green) brs. S.64°W., 69 ft. dist.
26" Larch (green) brs. West 11°

DESCRIBE CORNER LOCATION RELATIVE TO NEAR-BY FEATURES, ALSO HOW TO REACH CORNER

This corner bears about N.54°W. 500' from N. Pole Portal #1. It is CORNER #1 of the Central Placer and CORNER #1 of the Tacoma Cons Quartz Cl. (unpatented) It bears N27°30'E. 3 chs. from Corner #4 of the WILLAMETTE Placer instead of N.27°30'W. as the notes have it.

MITCHELL'S 1980 DESCRIPTION:

MONUMENT: DESCRIBE NEW MONUMENT SET, OR WORK DONE TO PRESERVE EXISTING MONUMENT

Planted $2\frac{1}{2}$ " B.C. on 1" x 32" gal pipe 24" deep in original hole in md of stone marked CPC C1 MS256 1980


ACCESSORIES: DESCRIBE NEW BT'S WITNESS OBJECTS ETC. ESTABLISHED, OR WORK DONE TO PRESERVE EXISTING EVIDENCE:

10" WF brs S9°W 31lks marked CPC1 MS256 B.T.

FILED September 24, 2025
BAKER COUNTY SURVEYOR
SURVEY NO. 8-37-215

RECORD OF LAND CORNER MONUMENTATION

CORNER #1 CENTRAL PLACER CLAIM, MINERAL SURVEY 256,
IDENTICAL WITH CORNER #1 THOMPSON QUARTZ CLAIM, MINERAL SURVEY 252 (UNPATENTED),
SITUATED IN SECTION 29, T. 8 S., R. 37 E., W.M.
PAGE 2 OF 2

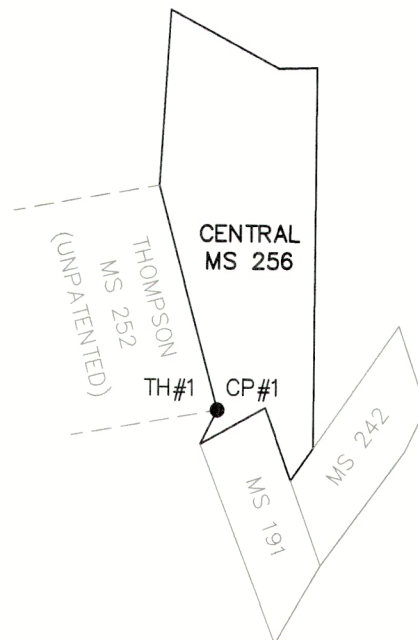

EVIDENCE FOUND: Found Mitchell's unrecorded monument, which is a 1 1/2" galvanized iron pipe with a 2 1/2" brass cap, marked as shown, projecting 3" above ground in a 3 ft. diameter mound of stone. From which, I also found the following bearing trees:

- ▶ A white fir stump, 10" diam, with rotted log alongside, bears S.09°W., 20.8 ft. (Mitchell BT).
- ▶ A dead and down (wind-thrown) white fir, 32" diam, bears S.12°W., 38 ft., with healed blaze. I removed the overgrowth to reveal a large blaze with scribing *COR 1* and *MS N 252 B* legible amongst other fragmentary scribe marks. Bearing and distance was measured to approximate center of root wad hole. (Original BT).
- ▶ A western larch, 23" dbh, bears N.86°W., 10.65 ft., with partially opened blaze with visible scribing *MS N* and other fragmentary scribe marks. Distance was measured to face of blaze. (Original BT).


DESCRIPTION OF MONUMENTS AND ACCESSORIES SET AND METHODS USED: I accept Mitchell's brass cap monument as a faithful and accurate perpetuation of the original corner, being harmoniously related to the original accessory evidence, and also to other found accepted corners of Mineral Survey 256. Cap is marked as shown.

From which, **I SCRIBE A NEW BEARING TREE:**

- ▶ A western larch, 10.5" dbh, bears N.55°23'E., 38.4 ft. marked X in upper blaze, and *BT* in lower blaze. Distance measured to a Mag Spike driven in the side-center-right at the root crown, with an attached 1 1/2" aluminum washer stamped *PLS 69454*.

Painted a 6 inch red band around the live bearing trees, and also painted blazes red, and attached new USFS 54-3 and 54-9 signs. Distances measured with an EDM device. Used RTK GPS to measure bearings. Bearings are geodetic, based on GPS observation taken at the corner. Set an aluminum guard post N.15°W., 5 ft., with USFS 54-2 sign attached, and another aluminum guard post S.27°W., 5.6 ft., with USFS 54-2 and 54-9 signs attached. See associated Map of Survey dated August 20, 2025 for survey-related information.

CORNER MONUMENT
MARKED:

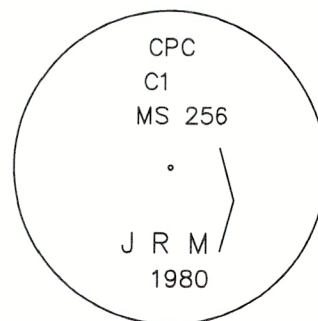

RESTORATION BY, STAMP AND DATE:

Work performed September 10, 2024
Survey completed August 20, 2025

Jason L. Hatfield, PLS
Spencer B. Jones, Survey Technician

USDA FOREST SERVICE
NORTHEAST OREGON LAND ZONE
1550 Dewey Avenue, Suite A
Baker City, OR 97814
(541) 523-1283

FILED September 24, 2025
BAKER COUNTY SURVEYOR
SURVEY NO. 8-37-215

