

RECORD OF LAND CORNER MONUMENTATION

CORNER #1 ORAZABA QUARTZ CLAIM, MINERAL SURVEY 336,
SITUATED IN SECTION 31, T. 8 S., R. 37 E., W.M.
PAGE 1 OF 2


ORIGINALLY ESTABLISHED BY: Charles M. Foster, U.S. Deputy Mineral Surveyor

MINERAL SURVEY NUMBER: 336

COMPLETION DATE: July 10, 1897

SUBSEQUENT SURVEYS:

- ▶ G.L.O. Retracement by Lincoln E. Wilkes, U.S. Cadastral Engineer, under Group No. 107, Approved May 26, 1927
- ▶ Corner search notes by John R. Mitchell, an unlicensed Survey Technician, as documented on U.S. Forest Service corner card dated 9/9/1969
- ▶ Unrecorded remonumentation by John R. Mitchell, an unlicensed Survey Technician, as documented on U.S. Forest Service corner card dated June 14, 1981

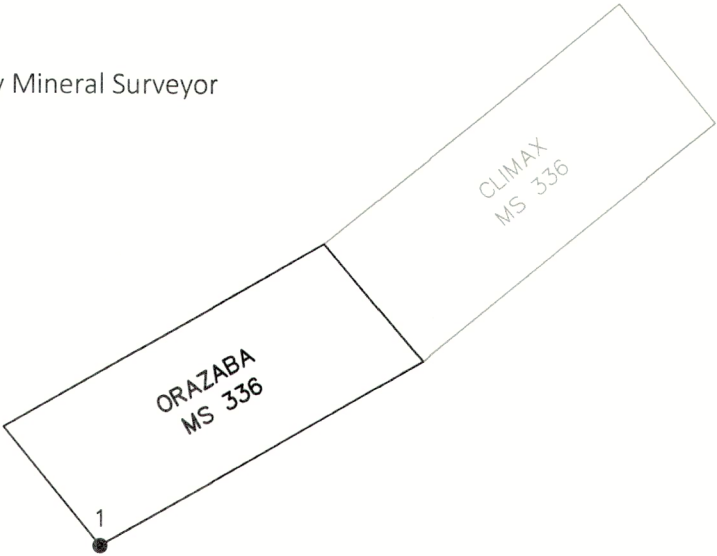

ORIGINAL DESCRIPTION: Beginning at Cor. No. 1. The original location corner which is a Post 4 ½ ft. long 4 inches square set 18 inches in the ground with mound of earth and stones scribed "1-336 Orazaba Claim".
A Blk Pine 24 inches in dia. bears S86°W 15 ft., Blazed and Scribed "1-336 Orazaba Claim"
A Tamarac 14 inches dia., bears S16°W 7 ft. Blazed and Scribed 1-336 Orazaba Claim.

G.L.O. DESCRIPTION: To cor. No. 1, as described.

MITCHELL'S 1969 DESCRIPTION:
DESCRIBE CORNER MONUMENT FOUND
mound of stone

DESCRIBE BEARING TREES OR OTHER OFFICIAL ACCESSORIES FOUND
22" W.L. brs. S.16°W. 7 ft.
40" P.P. brs. N.65°W. 15 ft.
Both with nearly full readable scribing

DESCRIBE CORNER LOCATION RELATIVE TO NEAR-BY FEATURES, ALSO HOW TO REACH CORNER
The surveyor mis-called the bearing on the P.P. when he wrote. The bearing was S.86°W. There is a good stand of mixed timber (Virgin) All the way around these claims.

MITCHELL'S 1981 DESCRIPTION:
DESCRIBE CORNER MONUMENT FOUND
Rotted post in md of E & S

DESCRIBE BEARING TREES OR OTHER OFFICIAL ACCESSORIES FOUND
21" WL fully scribed in open blaze brs S16°W 7' & 38" P.P. brs. N60°W 5' w/HB. The record call on this pine is S86°W 5'
Both with nearly full readable scribing

MONUMENT: DESCRIBE NEW MONUMENT SET, OR WORK DONE TO PRESERVE EXISTING MONUMENT
2 ½" BC on 1" X 32" gal. pipe set 28" deep in original hole & md marked ORA C1 MS 336 JRM 1981 & angle

ACCESSORIES: DESCRIBE NEW BT's WITNESS OBJECTS ETC. ESTABLISHED, OR WORK DONE TO PRESERVE EXISTING EVIDENCE
11" WF brs S87°E 14' marked ORA 1 MS 336 B.T.

FILED September 24, 2025
BAKER COUNTY SURVEYOR
SURVEY NO. 8-37-218

RECORD OF LAND CORNER MONUMENTATION

CORNER #3 CLIMAX QUARTZ CLAIM, MINERAL SURVEY 336,
IDENTICAL WITH CORNER #4 OHIO QUARTZ CLAIM, MINERAL SURVEY 381,
SITUATED IN SECTION 32, T. 8 S., R. 37 E., W.M.
PAGE 1 OF 2


ORIGINALLY ESTABLISHED BY: Charles M. Foster, U.S. Deputy Mineral Surveyor

MINERAL SURVEY NUMBER: 336

COMPLETION DATE: July 10, 1897

SUBSEQUENT SURVEYS:

- Mineral Survey 381 by Charles M. Foster, U.S. Deputy Mineral Surveyor, completed December 28, 1899
- Unrecorded remonumentation by John R. Mitchell, an unlicensed Survey Technician, as documented on U.S. Forest Service corner card dated June 12, 1981

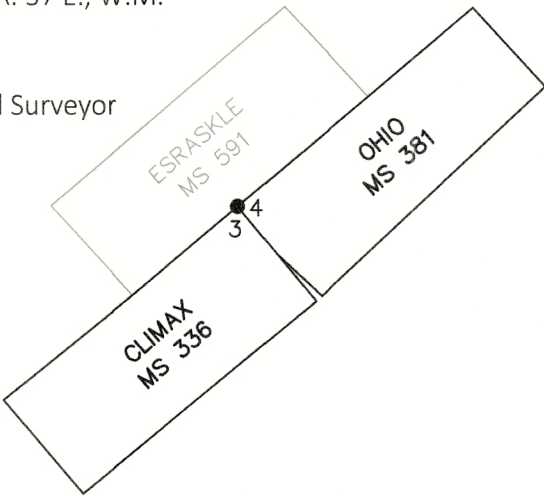

ORIGINAL DESCRIPTION: To Corner No. 3

A Post 4 1/2 ft. long 4 inches square set 18 inches in the ground with mound of earth scribed "3-336 Climax Claim"
Old location corner bears N49°E 12 ft distant
A Blk Pine 12 inches dia., bears S.67°30'W 20 ft distant scribed and blazed 3-336 BT
A Blk Pine 9 inches dia., bears S.31°W 22 ft

MS 381 DESCRIPTION: To cor. No. 4

Identical with cor. no. 3 of Climax Lode Survey No. 336
A pine post 4 ft. long, 4 ins. square, set 18 ins in the ground scribed cor. 4-181, whence
A pine 10 ins. dia. bears N83°45'E 27 ft. dist., blazed and scribed No. 4-381-BT
A pine 12 ins. dia. bears S45°45'E 25.5 ft. dist., blazed and scribed No. 4-381-BT

MITCHELL'S 1981 DESCRIPTION:


DESCRIBE CORNER MONUMENT FOUND: Rotting post in md of S&E
DESCRIBE BEARING TREES OR OTHER OFFICIAL ACCESSORIES FOUND: Dead 15" L.P.P. w/ full scribing brs S45°45'E 25 1/2'
MONUMENT: DESCRIBE NEW MONUMENT SET, OR WORK DONE TO PRESERVE EXISTING MONUMENT:
2 1/2" BC on 1" X 32" gal. pipe set 24" deep in original md & marked OHIO C4 MS 381 JRM 1981 & angle
ACCESSORIES: DESCRIBE NEW BT's WITNESS OBJECTS ETC. ESTABLISHED, OR WORK DONE TO PRESERVE EXISTING
EVIDENCE: 10" WF brs S21°E 26'; 10" WF brs S43°W 19' both marked OHIO 4 MS 381 BT

EVIDENCE FOUND: Found Mitchell's unrecorded monument, which is a 1 1/2" galvanized iron pipe with a 2 1/2" brass cap, marked as shown, projecting 7" above ground in a 2 ft. diameter mound of earth and stone, with steel T post w/ USFS 54-9 sign attached set alongside. From which,

- An Engelmann spruce, 10" dbh, bears S.43°W., 18.4 ft. with partially-healed single blaze (Mitchell BT)
- A lodgepole stump (broken off), bears S.45°30'E., 26 ft. to center, with rotted remains of the bole alongside with blaze and axe marks visible (Original BT)
- Other bearing tree by Mitchell is dead and down

I accept Mitchell's brass cap monument as a faithful and accurate perpetuation of the original corner, being harmoniously related to the found accessory evidence, and to other found accepted corners in the area. Used RTK GPS to measure accessories. Distance to live BT measured to side-center. Bearings are geodetic, based on GPS observation taken at the corner. See associated Map of Survey dated August 20, 2025 for survey-related information.

CORNER MONUMENT MARKED:

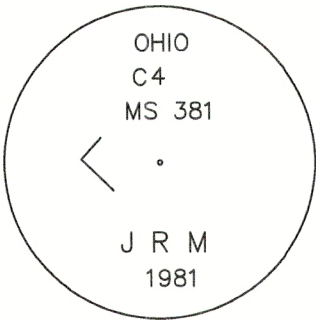

RESTORATION BY, STAMP AND DATE:

Work performed September 19, 2024
Survey completed August 20, 2025

Jason L. Hatfield, PLS

USDA FOREST SERVICE
NORTHEAST OREGON LAND ZONE
1550 Dewey Avenue, Suite A
Baker City, OR 97814
(541) 523-1283

FILED September 24, 2025
BAKER COUNTY SURVEYOR
SURVEY NO. 8-37-218

REGISTERED
PROFESSIONAL
LAND SURVEYOR

OREGON
NOVEMBER 30, 2007
JASON L. HATFIELD
#69454

EXPIRES: 6/30/2027