


RECORD OF LAND CORNER MONUMENTATION

WESTERLY-CENTER-END ORAZABA QUARTZ CLAIM, MINERAL SURVEY 336,
SITUATED IN SECTION 31, T. 8 S., R. 37 E., W.M.
PAGE 1 OF 2

ORIGINALLY ESTABLISHED BY: Charles M. Foster, U.S. Deputy Mineral Surveyor
MINERAL SURVEY NUMBER: 336
COMPLETION DATE: July 10, 1897

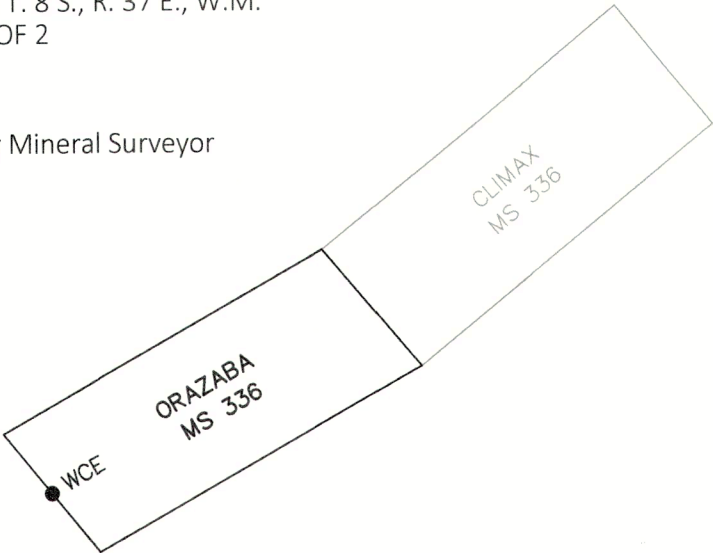

ORIGINAL DESCRIPTION: To Westerly Centre End Post

EVIDENCE FOUND: Found a 2 1/2 ft. diameter mound of earth and stone, 1 ft. high, with pieces of charred wood in the center, down to a depth of 18 inches. From which, I also found a western larch snag with what appeared to be a healed blaze facing the mound. I cut it open, removing the overgrowth to reveal an old blaze with full scribing, which read *W CENTRE POST ORAZABA CLAIM MS 336 BT*. I find the scribing to be consistent with other original bearing trees scribed by Foster. I accept the center of the mound for the corner position, being harmoniously related to Corners 1 and 2 of the Orazaba Claim.

DESCRIPTION OF MONUMENTS AND ACCESSORIES SET AND METHODS USED: At the corner point, I set a standard USFS 2 1/2" x 30" aluminum pipe with attached 3 1/4" aluminum cap, 26" in the ground. Fortified existing mound with more stones, to top of cap. Cap is marked as shown below.


From which, AN ORIGINAL UNRECORDED BEARING TREE:

- ▶ A western larch stump, 26" dbh, 4.5 ft. tall, bears S.11°W., 35.5 ft. with scribing *W CENTRE POST ORAZABA CLAIM MS 336 BT* visible in an opened blaze on the stump and down bole (distance measured to the face of the blaze).

Also from which, I SCRIBE NEW BEARING TREES:

- ▶ A Douglas-fir, 10" dbh, bears S.14°W., 10.0 ft. marked *X* in upper blaze and *BT* in lower blaze
- ▶ A white fir, 13" dbh, bears S.69°W., 19.08 ft. marked *ORA-WCE-336* in upper blaze and *XBT* in lower blaze

CORNER MONUMENT MARKED:

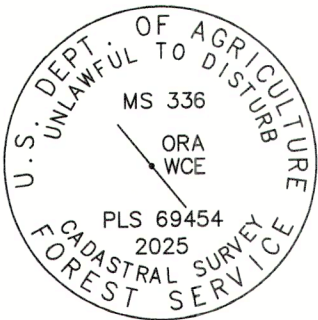

Placed a light blue plastic-encased magnet at the base of the aluminum pipe. Painted a 6 inch red band around the bearing trees, and also painted the blaze red, and attached new USFS 54-3 and 54-9 signs. Distances to new BT's measured with a steel tape to a Mag Spike driven in the side-center-right above the root crown, with an attached 1 1/2" aluminum washer stamped *PLS 69454*. Bearings are geodetic, based on GPS observation taken at the corner. Set an aluminum guard post S.39°E., 3.7 ft. with USFS 54-2 and 54-9 signs attached, and another guard post N.39°W., 2.7 ft., with USFS 54-9 sign attached. See associated Map of Survey dated August 20, 2025 for survey-related information.

RESTORATION BY, STAMP AND DATE:

Work performed July 9, 2025
Survey completed August 20, 2025

Jason L. Hatfield, PLS

USDA FOREST SERVICE
NORTHEAST OREGON LAND ZONE
1550 Dewey Avenue, Suite A
Baker City, OR 97814
(541) 523-1283

FILED September 24, 2025
BAKER COUNTY SURVEYOR
SURVEY NO. 8-37-219


REGISTERED
PROFESSIONAL
LAND SURVEYOR

OREGON
NOVEMBER 30, 2007
JASON L. HATFIELD
#69454

EXPIRES: 6/30/2027

RECORD OF LAND CORNER MONUMENTATION

CORNER #1 ORAZABA QUARTZ CLAIM, MINERAL SURVEY 336,
SITUATED IN SECTION 31, T. 8 S., R. 37 E., W.M.
PAGE 2 OF 2

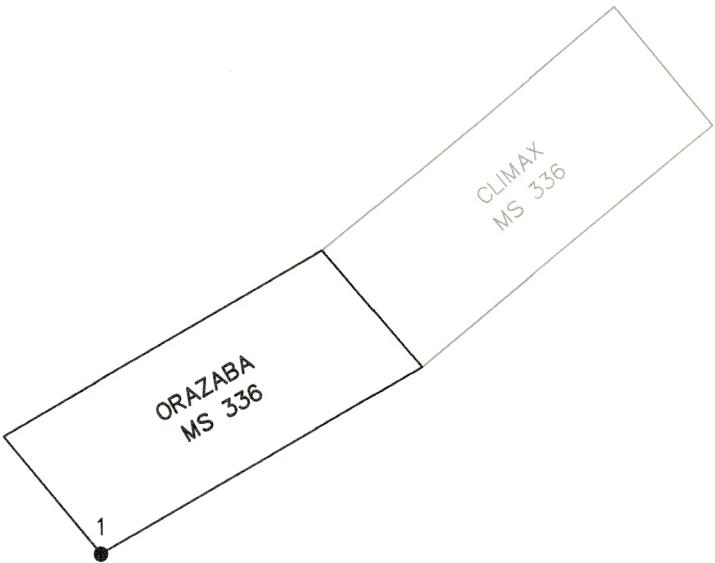


EVIDENCE FOUND: Found Mitchell's unrecorded monument, which is a 1 1/2" galvanized iron pipe with a 2 1/2" brass cap, marked as shown, projecting 1" above ground and appears to be in an embedded mound of earth and stone. From which,

- ▶ A white fir, 17" dbh, bears S.87°E., 14.05 ft. with fully-healed single blaze (Mitchell BT)
- ▶ A western larch snag, 18" dbh, bears S.20°W., 8.1 ft. (distance measured to blaze) with partial scribing *No 1 ORIZABA B* visible in an opened blaze (Original BT)
- ▶ A ponderosa pine, 42" dbh, bears N.60°W., 14.80 ft. with a fully-healed single blaze (Original BT)

DESCRIPTION OF MONUMENTS AND ACCESSORIES SET AND METHODS USED: I accept Mitchell's brass cap monument as a faithful and accurate perpetuation of the original corner, being harmoniously related to the found accessory evidence, and to other found accepted corners in the area.

CORNER MONUMENT
MARKED:

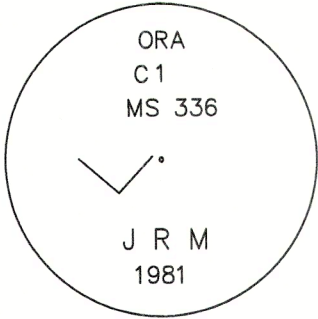

Painted a 6 inch red band around the bearing trees and also painted the blazes red, and attached new USFS 54-3 and 54-9 signs. Distances to live BT's measured with a steel tape to a Mag Spike driven in the side-center-right above the root crown, with an attached 1 1/2" aluminum washer stamped *PLS 69454*. Bearings are geodetic, based on GPS observation taken at the corner. Set an aluminum guard post N.60°E., 3.5 ft. with USFS 54-2 sign attached, and another one N.39°W., 3.1 ft., with USFS 54-2 and 54-9 signs attached. See associated Map of Survey dated August 20, 2025 for survey-related information.

RESTORATION BY, STAMP AND DATE:

Work performed July 10, 2025
Survey completed August 20, 2025

Jason L. Hatfield, PLS

USDA FOREST SERVICE
NORTHEAST OREGON LAND ZONE
1550 Dewey Avenue, Suite A
Baker City, OR 97814
(541) 523-1283

FILED September 24, 2025
BAKER COUNTY SURVEYOR
SURVEY NO. 8-37-219

REGISTERED
PROFESSIONAL
LAND SURVEYOR


OREGON
NOVEMBER 30, 2007
JASON L. HATFIELD
#69454
EXPIRES: 6/30/2027