

RECORD OF LAND CORNER MONUMENTATION

CORNER #3 ORAZABA QUARTZ CLAIM, MINERAL SURVEY 336,
IDENTICAL WITH CORNER #4 CLIMAX QUARTZ CLAIM, MINERAL SURVEY 336,
SITUATED IN SECTION 31, T. 8 S., R. 37 E., W.M.
PAGE 1 OF 2


ORIGINALLY ESTABLISHED BY: Charles M. Foster, U.S. Deputy Mineral Surveyor

MINERAL SURVEY NUMBER: 336

COMPLETION DATE: July 10, 1897

SUBSEQUENT SURVEYS:

- ▶ G.L.O. Retracement by Lincoln E. Wilkes, U.S. Cadastral Engineer, under Group No. 107, Approved May 26, 1927
- ▶ Corner search notes by John R. Mitchell, an unlicensed Survey Technician, as documented on U.S. Forest Service corner card dated 9/9/1969
- ▶ Unrecorded remonumentation by John R. Mitchell, an unlicensed Survey Technician, as documented on U.S. Forest Service corner card dated June 14, 1981

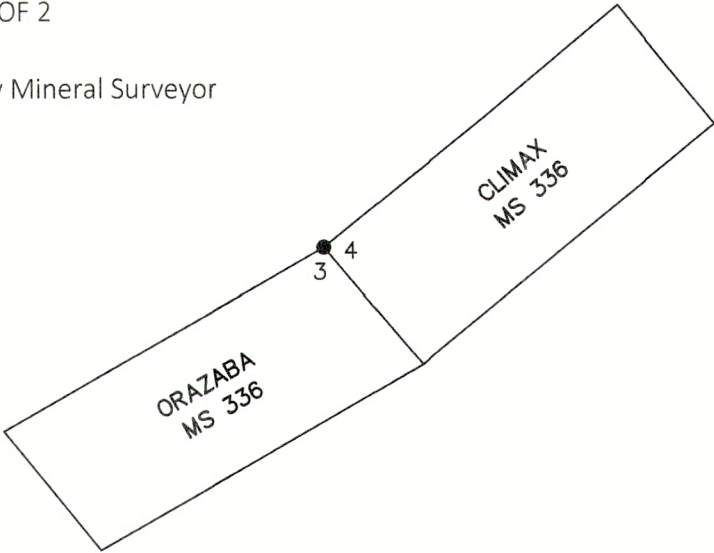

ORIGINAL DESCRIPTION: To Corner No. 4. A Post 4 1/2 ft. long 4 inches square set 18 inches in the ground with mound of rock and earth scribed "4-336-Climax Claim"
No original corner visible
A Tamarac 18 inches in dia., bears N30°W 10 ft blazed and scribed 4-336
A Tamarac 14 inches dia., bears S32°30'E 7 ft distant Blazed and scribed 4-336

G.L.O. DESCRIPTION: To cor. No. 3, common with cor. No. 4, Climax Claim, as described.

MITCHELL'S 1969 DESCRIPTION:
DESCRIBE CORNER MONUMENT FOUND
Post, 4 x 4, 16" above ground - good condition marked CLIMAX and ORAZABA

DESCRIBE BEARING TREES OR OTHER OFFICIAL ACCESSORIES FOUND
24" W.L. brs. N.30°W. 10 ft. w/scribing partially grown over.
26" W.L. brs. S.32°30'E., 7 w/ full scribing

MITCHELL'S 1981 DESCRIPTION:
DESCRIBE CORNER MONUMENT FOUND
Rotting post w/ scribing in md of E and stone

DESCRIBE BEARING TREES OR OTHER OFFICIAL ACCESSORIES FOUND
24" WL w/ full scribing in P.H.B. brs N30°W 10'
26" WL w/ full scribing in P.H.B. brs S32 1/2°E 7'


MONUMENT: DESCRIBE NEW MONUMENT SET, OR WORK DONE TO PRESERVE EXISTING MONUMENT
2 1/2" BC on 1" X 32" gal. pipe set 27" deep in original hole & md marked CLi C4 MS 336 JRM 1981 & angle

ACCESSORIES: DESCRIBE NEW BT's WITNESS OBJECTS ETC. ESTABLISHED, OR WORK DONE TO PRESERVE EXISTING EVIDENCE
9" WF brs S69°W 19' marked CLi 4 MS 336 BT

FILED September 24, 2025
BAKER COUNTY SURVEYOR
SURVEY NO. 8-37-220

RECORD OF LAND CORNER MONUMENTATION

CORNER #3 ORAZABA QUARTZ CLAIM, MINERAL SURVEY 336,
IDENTICAL WITH CORNER #4 CLIMAX QUARTZ CLAIM, MINERAL SURVEY 336,
SITUATED IN SECTION 31, T. 8 S., R. 37 E., W.M.
PAGE 2 OF 2

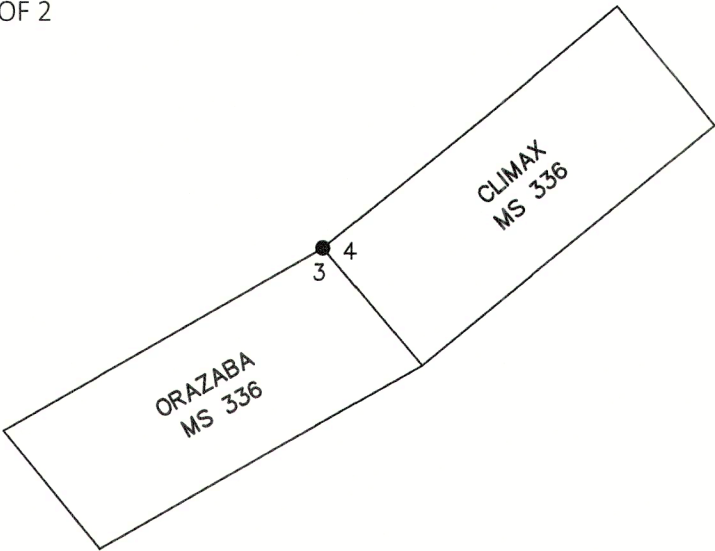


EVIDENCE FOUND: Found Mitchell's unrecorded monument, which is a 1 1/2" galvanized iron pipe with a 2 1/2" brass cap, marked as shown, projecting 4" above ground in an embedded collar of stone. From which,

- ▶ A western larch rotted stump, size indeterminate, bears N.32°W., 9.9 ft. (Original BT)
- ▶ A western larch, 26" dbh, bears S.32°E., 7.0 ft. with visible scribing in opened blaze (Original BT)
Distance measured to face of blaze
- ▶ A white fir, 17" dbh, bears S.67°W., 18.8 ft. with in a fully-healed single blaze (Mitchell BT)

DESCRIPTION OF MONUMENTS AND ACCESSORIES SET AND METHODS USED: I accept Mitchell's brass cap monument as a faithful and accurate perpetuation of the original corner, being harmoniously related to the found accessory evidence, and to other found accepted corners in the area.

CORNER MONUMENT
MARKED:

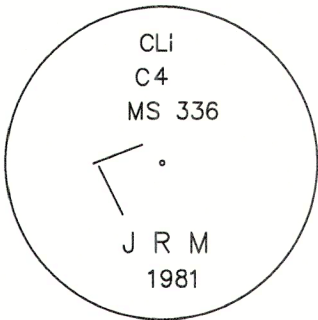

Painted a 6 inch red band around the bearing trees and also painted the blazes red, and attached new USFS 54-3 and 54-9 signs. Distances to bearing trees measured with a steel tape. Used a magnetic compass with 14° East declination to measure bearings. Set an aluminum guard post N.51°E., 5 ft. with USFS 54-2 and 54-9 signs attached, and another one S.60°W., 3 ft., with USFS 54-2 sign attached. See associated Map of Survey dated August 20, 2025 for survey-related information.

RESTORATION BY, STAMP AND DATE:


Work performed July 10, 2025
Survey completed August 20, 2025

Jason L. Hatfield, PLS

USDA FOREST SERVICE
NORTHEAST OREGON LAND ZONE
1550 Dewey Avenue, Suite A
Baker City, OR 97814
(541) 523-1283

FILED September 24, 2025
BAKER COUNTY SURVEYOR
SURVEY NO. 8-37-220

REGISTERED
PROFESSIONAL
LAND SURVEYOR

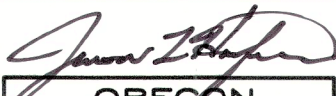
OREGON
NOVEMBER 30, 2007
JASON L. HATFIELD
#69454
EXPIRES: 6/30/2027