

RECORD OF LAND CORNER MONUMENTATION

CORNER #2 GOLCONDA QUARTZ CLAIM, MINERAL SURVEY 348,
IDENTICAL WITH CORNER #2 WIDE WEST LODE CLAIM, MINERAL SURVEY 378,
SITUATED IN SECTION 32, T. 8 S., R. 37 E., W.M.

PAGE 1 OF 2


ORIGINALLY ESTABLISHED BY: Arthur Philbrick, U.S. Deputy Mineral Surveyor

MINERAL SURVEY NUMBER: 348

COMPLETION DATE: July 13, 1898

SUBSEQUENT SURVEYS:

- ▶ Mineral Survey 378 by John Hagel, U.S. Deputy Mineral Surveyor, completed November 4, 1899
- ▶ G.L.O. Retracement by Lincoln E. Wilkes, U.S. Cadastral Engineer, under Group No. 107, Approved May 26, 1927
- ▶ Corner search notes by John R. Mitchell, an unlicensed Survey Technician, as documented on U.S. Forest Service corner card dated 9/9/1969
- ▶ Unrecorded remonumentation by John R. Mitchell, an unlicensed Survey Technician, as documented on U.S. Forest Service corner card (undated)
- ▶ Survey by Leland Myers, PLS #699, map filed December 22, 2003, as Survey No. 8-37-135 in the Baker County Surveyor's office

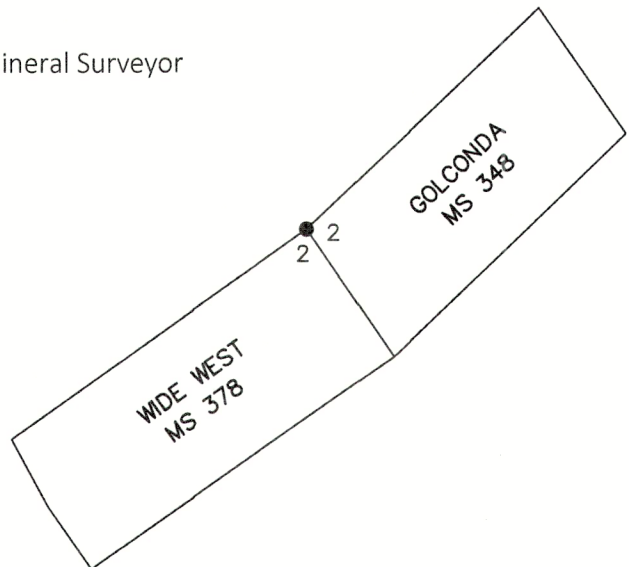

ORIGINAL DESCRIPTION: To Corner No. 2. A pine post 4 ft. long, 4 ins square, set 18 ins. in the ground with mound of earth scribed G-2-348 whence,
old location cor. bears N51°W 69.3 ft.
a black pine 18 ins diam bears S.9°30'W. 12 ft.
a black pine 12 ins diam bears N.78°45'W. 20.3 ft.
Each blazed and scribed G-2-348-B.T.

MS 378 DESCRIPTION: To Cor. No. 2 Identical with the N.E. location cor. Identical with Cor. No. 2 Golconda Lode Sur. 348 Found a white fir post 4 ins. square 3 ft. above the ground, with a mound of rocks and earth around it, marked Golconda C.2-348, marked it W.West C.2-378
a white fir tree 10 ins. in diam. bears N.11°50'E. 31.1 ft.
a white fir tree 12 ins. in diam. bears N.63°10'W. 16.9 ft.
Both blazed and marked W.West C.2-378 B.T.

G.L.O. DESCRIPTION: To cor. No. 2, Wide West Claim, common with cor. No. 2, Golconda Claim, Sur. No. 348, as described.

MITCHELL'S 1969 DESCRIPTION:

DESCRIBE CORNER MONUMENT FOUND

Post, 5 x 5 - Down and rotted.

DESCRIBE BEARING TREES OR OTHER OFFICIAL ACCESSORIES FOUND

18" W.F. (Down) brs N63°10'W. 16.9 ft.
14" L.P.P., 5' high, brs N.78°45'W. 20.5 ft.
20" L.P.P. brs. S.9°30'W. 20.3 ft.
ALL THREE TREES W/ SCRIBING

MITCHELL'S 1981 DESCRIPTION:

MONUMENT: DESCRIBE NEW MONUMENT SET, OR WORK DONE TO PRESERVE EXISTING MONUMENT

2 ½" BC on 1" X 32" gal. pipe 20" deep in md of earth & stone & marked WW C2 MS 378 JRM 1981 & angle

ACCESSORIES: DESCRIBE NEW BT's WITNESS OBJECTS ETC. ESTABLISHED, OR WORK DONE TO PRESERVE EXISTING EVIDENCE

10" WF brs S70°W 11 ½' marked WW2 MS 378 BT
5" WF brs N9°W 10' marked X BT


FILED September 24, 2025

BAKER COUNTY SURVEYOR

SURVEY NO. 8-37-222

RECORD OF LAND CORNER MONUMENTATION

CORNER #2 GOLCONDA QUARTZ CLAIM, MINERAL SURVEY 348,
IDENTICAL WITH CORNER #2 WIDE WEST QUARTZ CLAIM, MINERAL SURVEY 378,
SITUATED IN SECTION 32, T. 8 S., R. 37 E., W.M.
PAGE 2 OF 2

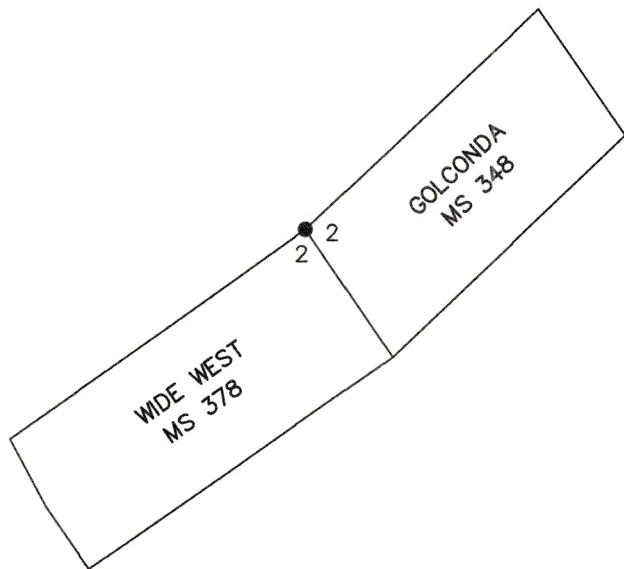


EVIDENCE FOUND: Found Mitchell's monument, which is a 1 1/2" galvanized iron pipe with a 2 1/2" brass cap, with Mitchell's markings obliterated by Myers, marked as shown, projecting 4" above ground in a 2 ft. diameter mound of stone. From which,

- ▶ A white fir, 12.5" dbh, bears S.70°W., 11.32 ft., with healed single blaze (Mitchell BT)
- ▶ A white fir, 9" dbh, bears N.09°W., 10.45 ft., with healed single blaze (Mitchell BT)

DESCRIPTION OF MONUMENTS AND ACCESSORIES SET AND METHODS USED: I accept Mitchell's brass cap monument as a faithful and accurate perpetuation of the original corner, being harmoniously related to the found accessory evidence, and to other found accepted corners in the area.

CORNER MONUMENT MARKED:

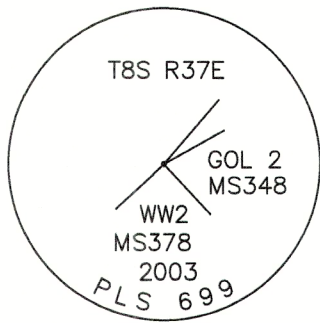

Painted a 6 inch red band around the bearing trees and also painted the blazes red, and attached new USFS 54-3 and 54-9 signs. Distances measured with a steel tape to a 60d galvanized spike with attached 1 1/2" aluminum washer stamped PLS 699 found driven in the side-center at the base of each tree. Used a magnetic compass with 14° East declination to measure bearings. Set an aluminum guard post N.47°E., 4 ft. with USFS 54-2 sign attached, and another one S.55°W., 4 ft., with USFS 54-2 and 54-9 signs attached. See associated Map of Survey dated August 20, 2025 for survey-related information.

RESTORATION BY, STAMP AND DATE:

Work performed August 26, 2024
Survey completed August 20, 2025

Jason L. Hatfield, PLS

USDA FOREST SERVICE
NORTHEAST OREGON LAND ZONE
1550 Dewey Avenue, Suite A
Baker City, OR 97814
(541) 523-1283

FILED September 24, 2025
BAKER COUNTY SURVEYOR
SURVEY NO. 8-37-222

REGISTERED
PROFESSIONAL
LAND SURVEYOR


OREGON
NOVEMBER 30, 2007
JASON L. HATFIELD
#69454
EXPIRES: 6/30/2027