


RECORD OF LAND CORNER MONUMENTATION

CORNER #1 CYCLONE QUARTZ CLAIM, MINERAL SURVEY 366,
SITUATED IN SECTION 32, T. 8 S., R. 37 E., W.M.
PAGE 1 OF 2

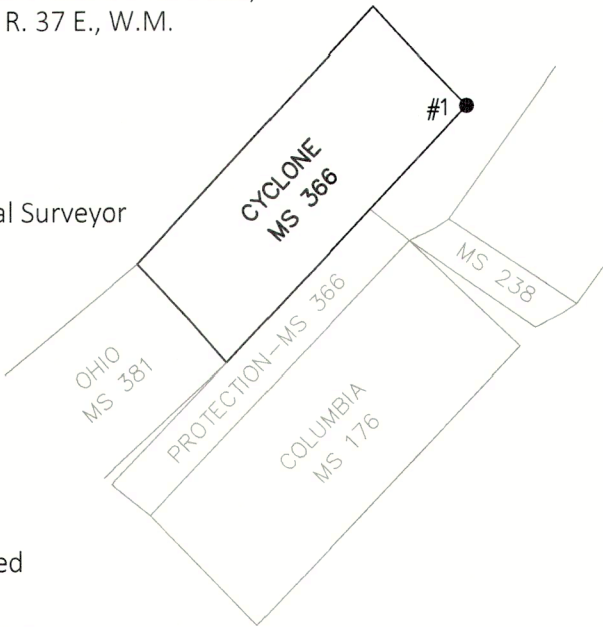

ORIGINALLY ESTABLISHED BY: Charles M. Foster, U.S. Deputy Mineral Surveyor

MINERAL SURVEY NUMBER: 366

COMPLETION DATE: August 18, 1899

SUBSEQUENT SURVEYS:

- ▶ G.L.O. Retracement by Lincoln E. Wilkes, U.S. Cadastral Engineer, under Group No. 107, Approved May 26, 1927
- ▶ Corner search notes by John R. Mitchell, an unlicensed Survey Technician, as documented on U.S. Forest Service corner card dated 8/27/1969
- ▶ Unrecorded remonumentation by John R. Mitchell, an unlicensed Survey Technician, as documented on U.S. Forest Service corner card dated 6/29/1981

ORIGINAL DESCRIPTION: Beginning at Cor. No. 1. A Post 4 1/2 feet long 4 inches square set 18 inches in the ground with mound of earth & stones scribed Cor. No. 1 - 366
Whence U.S. Mineral Monument No. 1 bears S.4°45'E. 446 feet.
A Fir 26" dia bears N57°W 55 ft. blazed and scribed Cor No. 1 - 366 B.T.

G.L.O. DESCRIPTION: Cor. No. 1, as described

MITCHELL'S 1969 DESCRIPTION:
DESCRIBE CORNER MONUMENT FOUND
mound of stone

DESCRIBE BEARING TREES OR OTHER OFFICIAL ACCESSORIES FOUND
32" green fir bears W. 55' / with full scribing. This B.T. on the ridge between Cracker Cr. and Fruit Cr.

MITCHELL'S 1981 DESCRIPTION:
DESCRIBE CORNER MONUMENT FOUND
None

DESCRIBE BEARING TREES OR OTHER OFFICIAL ACCESSORIES FOUND
34" gr DF w/ scribing in open blaze


MONUMENT: DESCRIBE NEW MONUMENT SET, OR WORK DONE TO PRESERVE EXISTING MONUMENT
2 1/2" BC on 1" X 32" gal. pipe set 15" deep in md of Stone & Earth marked CY C1 366 JRM 1981 & angle

ACCESSORIES: DESCRIBE NEW BT'S WITNESS OBJECTS ETC. ESTABLISHED, OR WORK DONE TO PRESERVE EXISTING EVIDENCE:
10" DF brs S25°E 35'
11" DF brs S53°W 18 1/2' both marked CYC1 MS 366 BT

FILED September 24, 2025
BAKER COUNTY SURVEYOR
SURVEY NO. 8-37-224

RECORD OF LAND CORNER MONUMENTATION

CORNER #1 CYCLONE QUARTZ CLAIM, MINERAL SURVEY 366,
SITUATED IN SECTION 32, T. 8 S., R. 37 E., W.M.
PAGE 2 OF 2

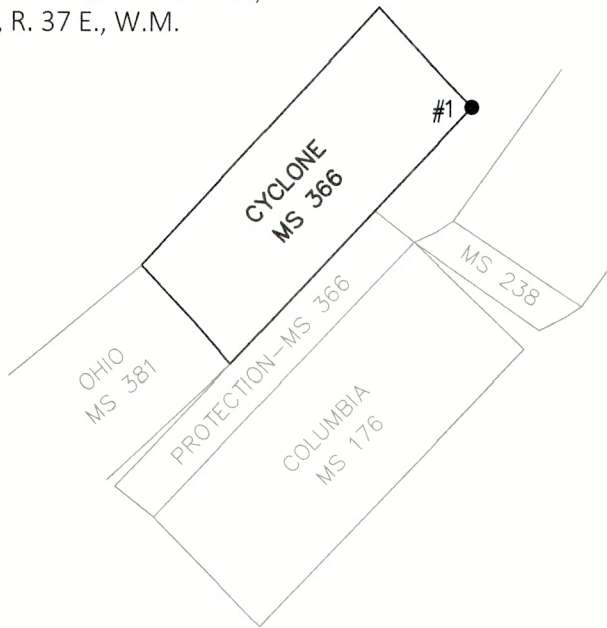


EVIDENCE FOUND: Found Mitchell's unrecorded monument, which is a 1 1/2" galvanized iron pipe with a 2 1/2" brass cap, marked as shown, projecting 16" above ground in a loose mound of stone. Stabilized the monument and repaired the mound of stone, 3 ft. base to top. From which,

- ▶ A Douglas-fir, 12" dbh, bears S.27°E, 34.1 ft., with fully-healed single blaze (Mitchell BT)
- ▶ A Douglas-fir, 14" dbh, bears S.50°W., 18.56 ft., with fully-healed single blaze (Mitchell BT)
- ▶ A Douglas-fir, dead and down (wind-thrown), 30"+/- diameter, with scribing 366 visible in an opened blaze, center of the root wad hole bears N.53°W., 55 ft.+/- (Original BT)

DESCRIPTION OF MONUMENTS AND ACCESSORIES SET AND METHODS USED: I accept Mitchell's brass cap monument as a faithful and accurate perpetuation of the original corner, being harmoniously related to the found accessory evidence, and to other found accepted corners in the area.

I painted a 6 inch red band around each of Mitchell's bearing trees, and also painted the healed blazes red, and attached new USFS 54-3 and 54-9 signs. Distances to Mitchell's BT's were measured with a steel tape to a Mag Spike driven in the side-center-right at the root crown of each tree, with an attached 1 1/2" aluminum washer stamped *PLS 69454*. Used RTK GPS to measure bearings. Bearings are geodetic, based on GPS observation taken at the corner. Set an aluminum guard post S.43°W. with USFS 54-2 and 54-9 signs attached, and another post N.45°W., 2 ft. with USFS 54-2 sign attached. See associated Map of Survey dated August 20, 2025 for survey-related information.

CORNER MONUMENT
MARKED:

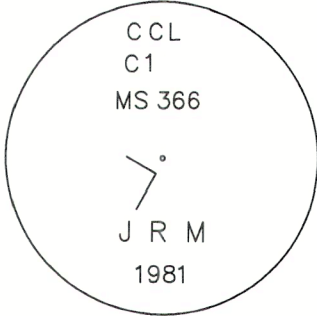

RESTORATION BY, STAMP AND DATE:

Work completed August 20, 2025

Jason L. Hatfield, PLS
Daniel B. Lee, Survey Technician

USDA FOREST SERVICE
NORTHEAST OREGON LAND ZONE
1550 Dewey Avenue, Suite A
Baker City, OR 97814
(541) 523-1283

FILED September 24, 2025
BAKER COUNTY SURVEYOR
SURVEY NO. 8-37-224

REGISTERED
PROFESSIONAL
LAND SURVEYOR

OREGON
NOVEMBER 30, 2007
JASON L. HATFIELD
#69454

EXPIRES: 6/30/2027