

RECORD OF LAND CORNER MONUMENTATION

CORNER #2 CYCLONE QUARTZ CLAIM, MINERAL SURVEY 366,
IDENTICAL WITH CORNER #1 OHIO QUARTZ CLAIM, MINERAL SURVEY 381
SITUATED IN SECTION 32, T. 8 S., R. 37 E., W.M.
PAGE 1 OF 2


ORIGINALLY ESTABLISHED BY: Charles M. Foster, U.S. Deputy Mineral Surveyor

MINERAL SURVEY NUMBER: 366

COMPLETION DATE: August 18, 1899

SUBSEQUENT SURVEYS:

- ▶ Mineral Survey 381 by Charles M. Foster, U.S. Deputy Mineral Surveyor, completed December 28, 1899
- ▶ Unrecorded remonumentation by John R. Mitchell, an unlicensed Survey Technician, as documented on U.S. Forest Service corner card dated 7/3/1981

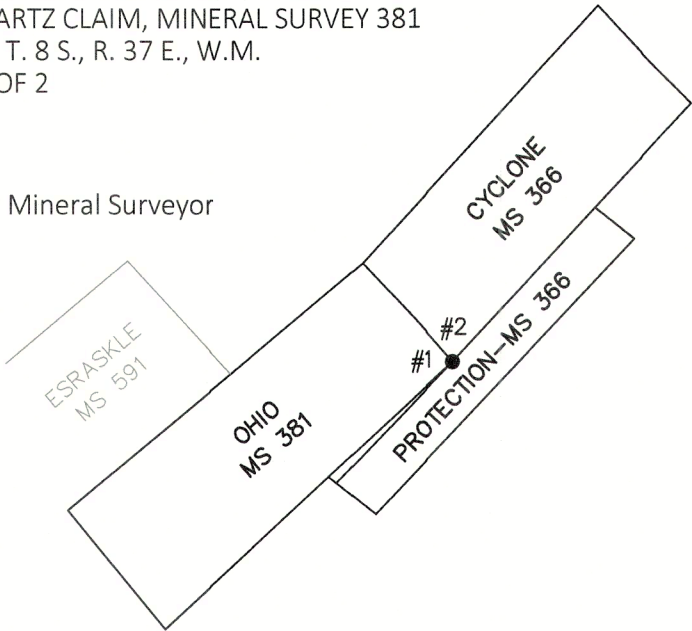

ORIGINAL DESCRIPTION: To Cor. No. 2. Identical with old corner A Post 4 1/2 feet long 4 inches square set 18 inches in the ground with mound of earth scribed Cor No 2 - 366
A Tamarac 20" dia bears S83°W 16 ft. blazed & scribed Cor No. 2 - 366 BT

MS 381 DESCRIPTION: Beginning at Corner No. 1. Identical with original S.E. corner of location and identical with corner no. 2 of Cyclone Lode Survey No. 366.
A fir post 4 ft. long, 4 ins. square, set 18 ins. in the ground, scribed 1 - 381, whence U.S. Mineral Monument No. 1 bears N60°50'E 1114 ft.
A tamarack 20 in diam. bears S79°45'W 16 ft. dist., blazed and scribed No. 1 - 381, B.T.
A tamarack 12 in dia. bears S29°45'E 18.5 ft. dist., blazed and scribed No. 1 - 381, B.T.

MITCHELL'S 1981 DESCRIPTION:
DESCRIBE CORNER MONUMENT FOUND
Rotted post in md of S & E

DESCRIBE BEARING TREES OR OTHER OFFICIAL ACCESSORIES FOUND
14" 7' W.L. stump fully scribed brs S29°45'E 18 1/2 '
24" W.L. stump brs S83°W 16'

MONUMENT: DESCRIBE NEW MONUMENT SET, OR WORK DONE TO PRESERVE EXISTING MONUMENT
2 1/2" BC on 1" X 32" gal. pipe set 25" deep in original hole & md marked CYC 2 MS 366 JRM 1981 & angle


ACCESSORIES: DESCRIBE NEW BT's WITNESS OBJECTS ETC. ESTABLISHED, OR WORK DONE TO PRESERVE EXISTING EVIDENCE
10" WF brs S56°E 21'
12" WF brs N85°E 25' both marked CYC 2 MS 366 B.T.

EVIDENCE FOUND: The corner position falls on the cut bank of a logging road. I searched for but found no trace of Mitchell's monument. I did however, find both of Mitchell's bearing trees, alive and vigorous. I also found the original bearing tree in the southwest quadrant from MS 366, consisting of the weathered remains of a western larch stump (size indeterminate). The other bearing tree described in MS 381 in the southeast quadrant falls within the road prism and has been destroyed. I accept the bearing trees as sufficient accessory evidence of the original corner, and reestablish the corner position by distance-distance intersection from Mitchell's bearing trees.

FILED September 24, 2025
BAKER COUNTY SURVEYOR
SURVEY NO. 837-225

RECORD OF LAND CORNER MONUMENTATION

CORNER #2 CYCLONE QUARTZ CLAIM, MINERAL SURVEY 366,
IDENTICAL WITH CORNER #1 OHIO QUARTZ CLAIM, MINERAL SURVEY 381
SITUATED IN SECTION 32, T. 8 S., R. 37 E., W.M.
PAGE 2 OF 2

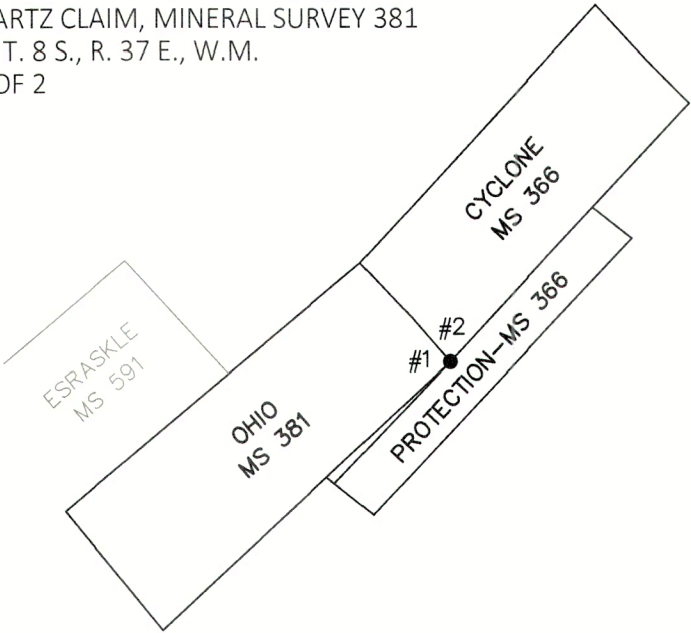

DESCRIPTION OF MONUMENTS AND ACCESSORIES SET AND METHODS USED: At the corner point, I set a standard USFS 2 1/2" x 30" aluminum pipe with attached 3 1/4" aluminum cap, 22" in the ground. Built a 3 ft. diameter mound of stone around the monument to top of cap. Cap is marked as shown below.


From which, **MITCHELL'S BEARING TREES:**

- A white fir, 23" dbh, bears N.82°46'E., 25.0 ft., with fully-healed single blaze
- A white fir, 20" dbh, bears S.54°55'E., 21.0 ft., with fully-healed single blaze

Also from which, **THE ORIGINAL BEARING TREE:**

- The weathered remains of a western larch stump, size indeterminate, bears S.83°W., 16 ft.

CORNER MONUMENT MARKED:

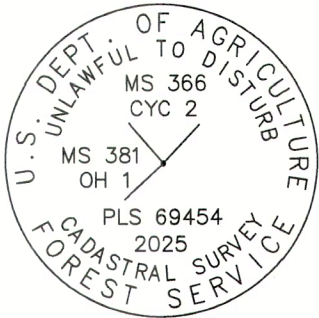

Placed a light blue plastic-encased magnet at the base of the aluminum pipe. Painted a 6 inch red band around Mitchell's bearing trees, and also painted the healed blazes red, and attached new USFS 54-3 and 54-9 signs. Distances to Mitchell's BT's measured with a steel tape to a Mag Spike driven in the side-center-right above the root crown, with an attached 1 1/2" aluminum washer stamped PLS 69454. Bearings are geodetic, based on GPS observation taken at the corner. Set an aluminum guard post NW and alongside, with USFS 54-9 sign attached. See associated Map of Survey dated August 20, 2025 for survey-related information.

RESTORATION BY, STAMP AND DATE:


Work performed June 5, 2025
Survey completed August 20, 2025

Jason L. Hatfield, PLS

USDA FOREST SERVICE
NORTHEAST OREGON LAND ZONE
1550 Dewey Avenue, Suite A
Baker City, OR 97814
(541) 523-1283

FILED September 24, 2025
BAKER COUNTY SURVEYOR
SURVEY NO. 8-37-225

REGISTERED
PROFESSIONAL
LAND SURVEYOR

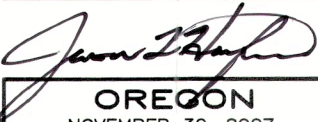

OREGON
NOVEMBER 30, 2007
JASON L. HATFIELD
#69454

EXPIRES: 6/30/2027